

SITE LAYOUT PLAN
SCALE 1:200

ROCKHAMPTON REGIONAL COUNCIL
APPROVED PLANS
These plans are approved subject to the current conditions of approval associated with
Development Permit No.: D/39--2022
Dated: 19 October 2022

REV	DATE	BY	CHKD	DESCRIPTION
1	07/22	LM	AB	AS CONSTRUCTED
2	25/07/22	LM	AB	

DESIGN CHECK: **MOLONEY SOLUTIONS PTY LTD 2022**
COPYRIGHT: **MOLONEY SOLUTIONS PTY LTD 2022**
DRAWN CHECK: **MOLONEY SOLUTIONS PTY LTD 2022**


DATE: **AS CONSTRUCTED**
PROJECT NO: **CE22001**

AS CONSTRUCTED
APPROVED: **FOR & ON BEHALF OF MOLONEY & SONS ENGINEERING**

CLIENT: **MOLONEY & SONS ENGINEERING**
PROJECT: **PROPOSED TEMPORAL BLASTING & PAINTING FACILITY ROCKHAMPTON - QLD**

DRAWING TITLE: **EXISTING SITE LAYOUT**
DRAWING NUMBER: **CE22001-SK01**
ISSUE: **A**

ROCKHAMPTON REGIONAL COUNCIL
APPROVED PLANS
 These plans are approved subject to the current conditions of approval associated with
Development Permit No.: D/39-2022
Dated: 19 October 2022

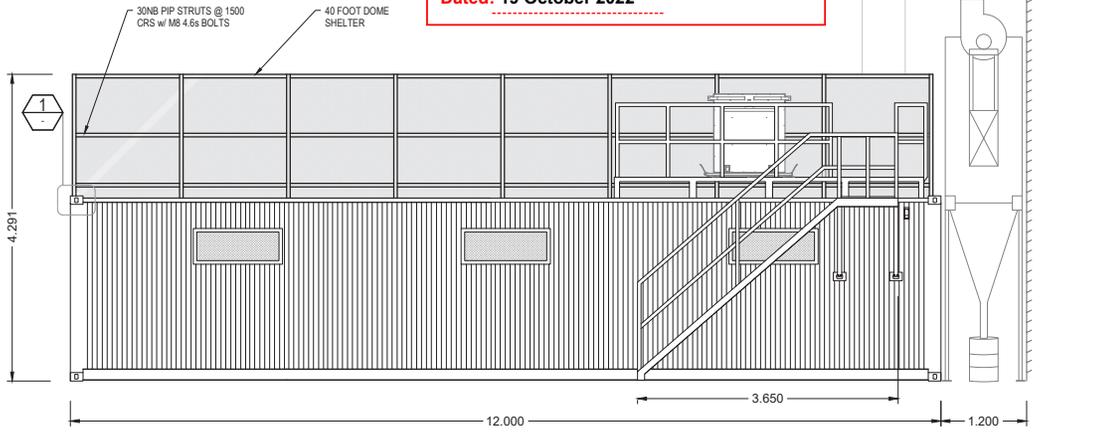


ELEVATION PLAN VIEW
 NTS



DETAIL
 SCALE 1: NTS



VIEW
 SCALE 1: NTS

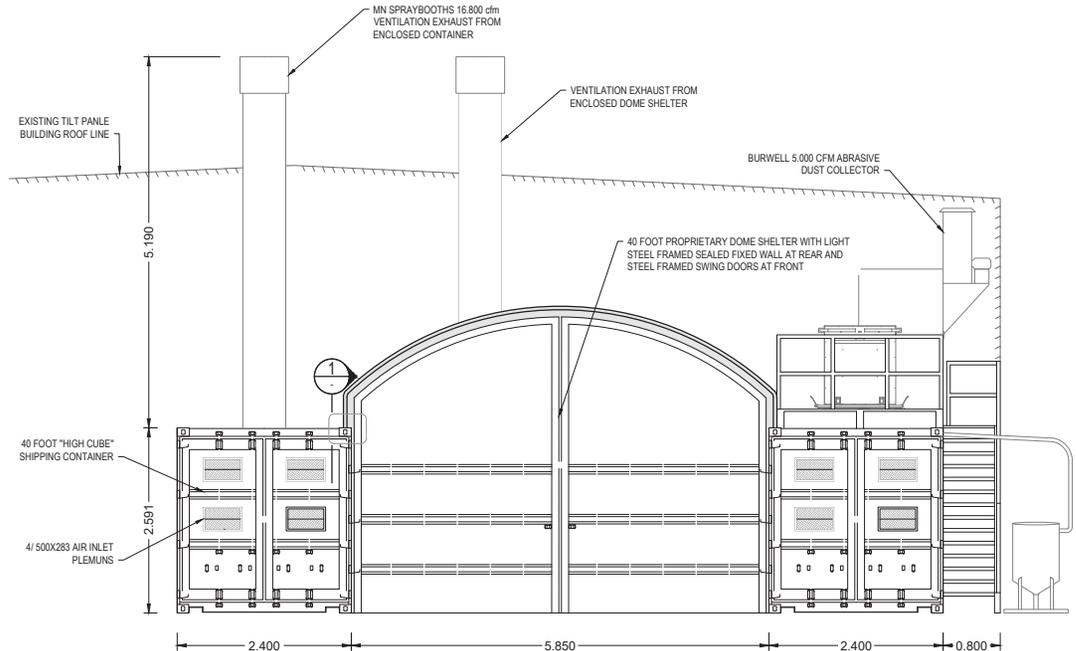

CROSS SECTION VIEW
 NTS

ISSUE	DATE	BY	DESCRIPTION
1	07/22	LM	AMENDMENT DETAILS
2	25/07/22	LM	AS CONSTRUCTED

DESIGN CHECK: **COPYRIGHT**
 MOLONEY SOLUTIONS PTY LTD 2022
 These designs and drawings are copyright and are not to be used or reproduced without the written permission of the design. The drawings or drawings are electronically generated, are confidential and may only be used for the purposes for which they were intended. This is an uncontrolled document issued for information purposes only, unless the checked sections are agreed and approved. Figure dimensions take precedence over scale. Do not scale from this drawing. Verify dimensions prior to commencing any work.

PROJECT NO: **CE22001**

AS CONSTRUCTED

CLIENT: **MOLONEY & SONS ENGINEERING**
 PROJECT: **PROPOSED TEMPORAL BLASTING & PAINTING FACILITY ROCKHAMPTON - QLD**

MOLONEY & SONS ENGINEERING
 EXCELLENCE - INTEGRITY - INNOVATION
 P.O. Box 3203 RED HILL ROCKHAMPTON, Q 4701
 www.moloneyandsons.com.au
 ROCKHAMPTON - GLADSTONE - ROCKA - MILES - CHINCHILLA - BRISBANE
 GOLD COAST - COFFS HARBOUR - STONEY

DRAWING TITLE: **TYPICAL SECTIONS & DETAILS**
 DRAWING NUMBER: **CE22001-SK02**
 ISSUE: **A**