

R.P.D.
 Lot Number : 1
 Reg./Survey Plan Number : 607283
 Locality : Rockhampton
 Local Government : Livingstone
 Area : 355.5m²

ROCKHAMPTON REGIONAL COUNCIL


APPROVED PLANS

These plans are approved subject to the current conditions of approval associated with

Development Permit No.: D/73-2021

Dated: 6 August 2021

DENISON STREET

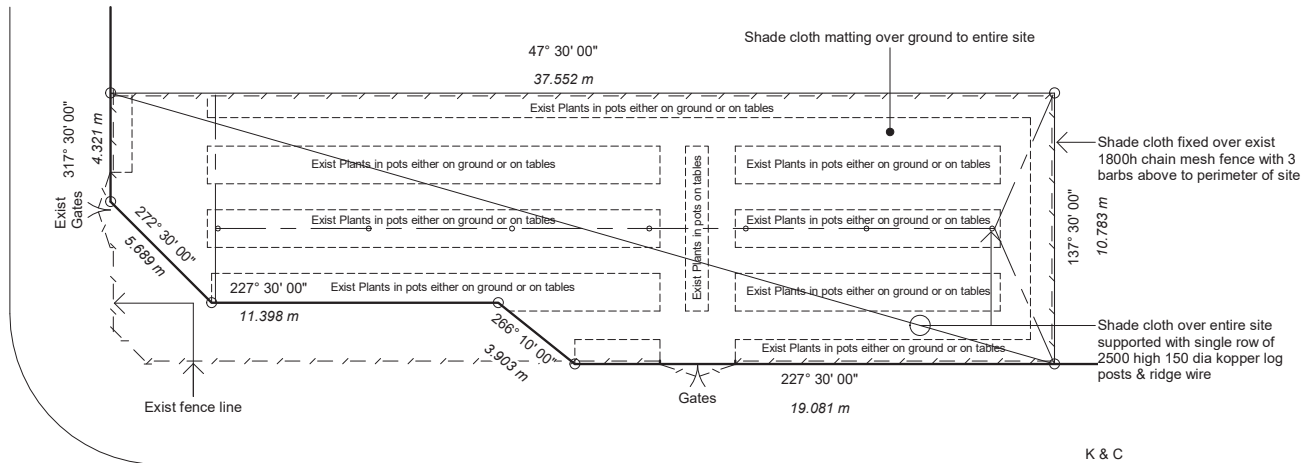

SOUTH STREET

1 Site Plan
 1 : 200

REVISIONS	No.	DESCRIPTION	DATE
C		USE OF ROAD RESERVE REMOVED	24/06/21
B		PROPERTY BOUNDARIES UPDATED	24/06/21
A		DEVELOPMENT APPROVAL	18/02/21

AS CONSTRUCTED NURSERY FOR GREENSCENE NURSERY AT 273 DENISON STREET ROCKHAMPTON



MEMBER BUILDING DESIGNERS ASSOC. OF QLD INC. Licensed under the QBSA Act Lic No. 1180286
 Telephone 61 7 49288011
 Facsimile 61 7 49266579
 E-mail mailbox@rufusdesigngroup.com

PROJECT MANAGER : *DanAbb*
 DRAWN : *DanAbb*
 CHKD : *T.J.R.*

WIND SPEED	C1	PROJECT NUMBER	200702 - 01
PLAN SIZE:	A3	SHEET	01 OF 01 SHEETS
REVISION	C		