


R.P.D.
 Lot Number : 12
 Reg./Survey Plan Number : RP603082
 Parish : Rockhampton
 County : Livingstone
 Area : 771.0sqm

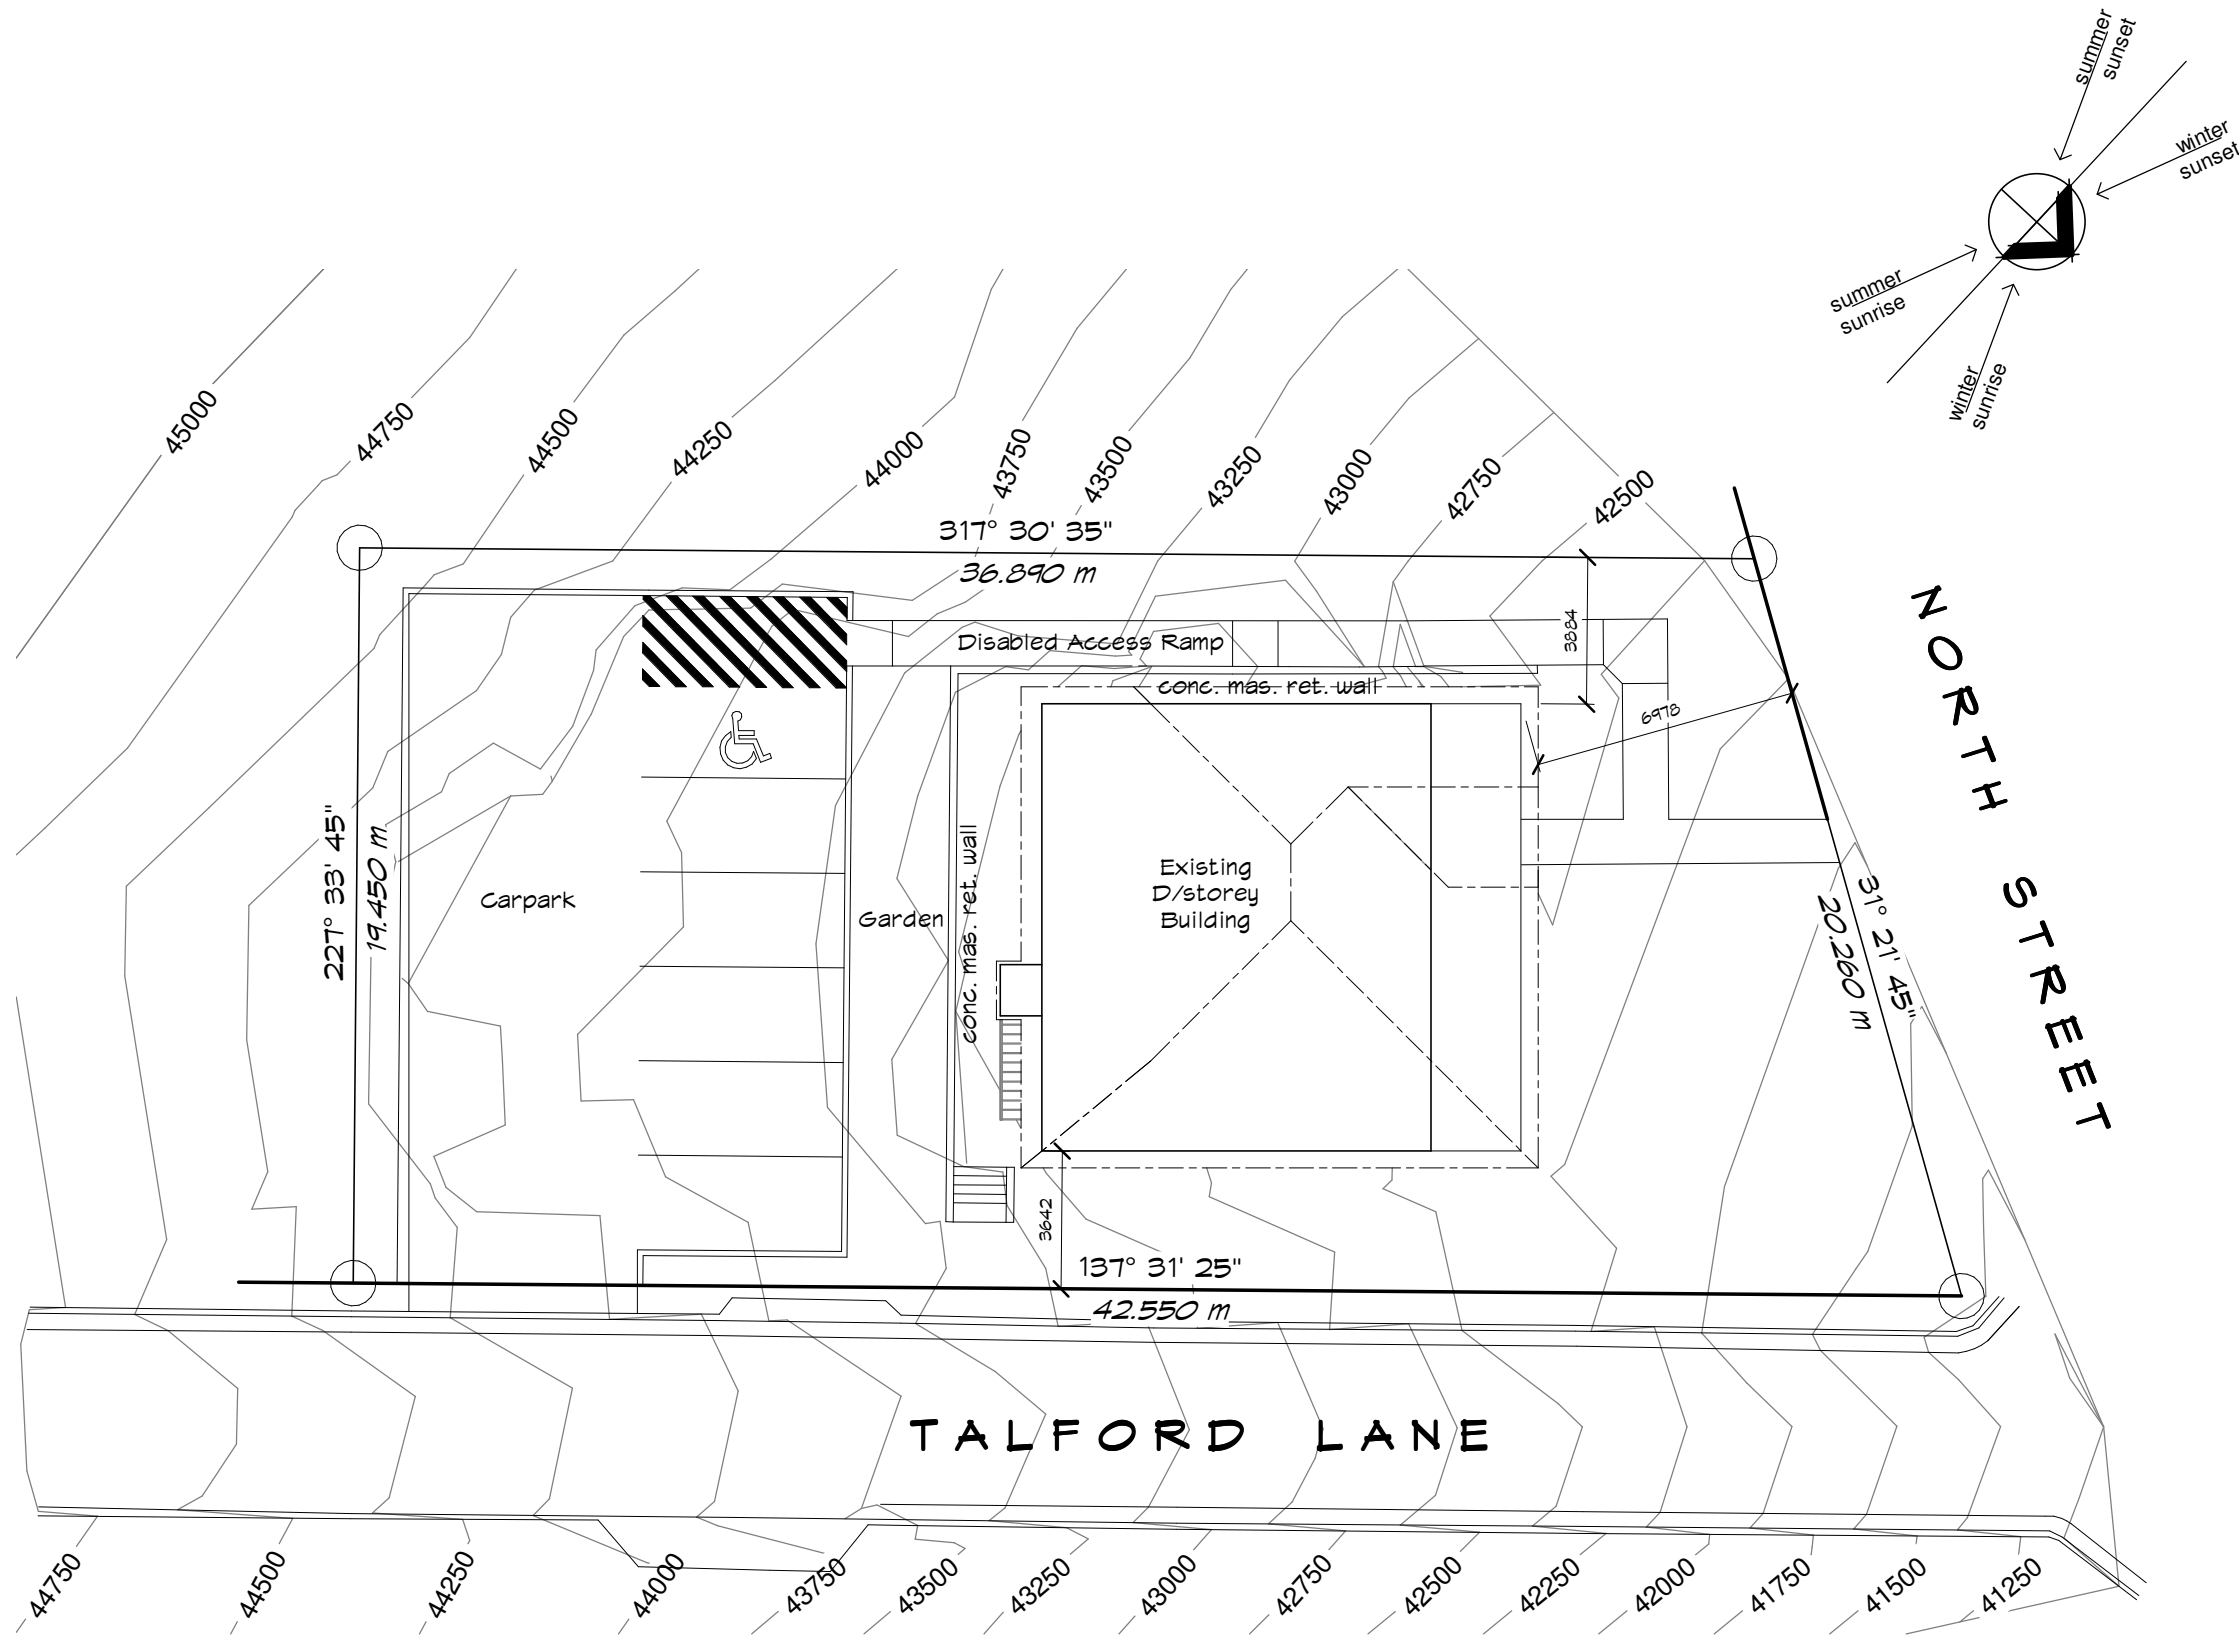

1 Site Plan
 1 : 200

ROCKHAMPTON REGIONAL COUNCIL
AMENDED PLANS APPROVED
 19 February 2018
 DATE
 These plans are approved subject to the current conditions of approval associated with
Development Permit No: D/78-2015
 Dated: 13 July 2015



REVISIONS	No.	DESCRIPTION	DATE
	A	FOR APPROVAL	24/01/18

**AS CONSTRUCTED MEDICAL SUITE
 FOR DR. P. ROFE
 AT 67 NORTH STREET,
 ROCKHAMPTON**

Rufus Design Group
 MEMBER BUILDING DESIGNERS ASSOC. OF QLD
 Licenced under the QBSA Act Lic No. 1180286
 Telephone 61 7 49288011
 Facsimile 61 7 49266579
 E-mail mailbox@rufusdesigngroup.com

PROJECT MANAGER : T.J.R.
 DRAWN : I.L.V.
 CHKD : T.J.R.

WIND SPEED	N/A	PROJECT NUMBER	171111 - 01
PLAN SIZE:	A3	SHEET 01 OF 03 SHEETS	
REVISION	A		

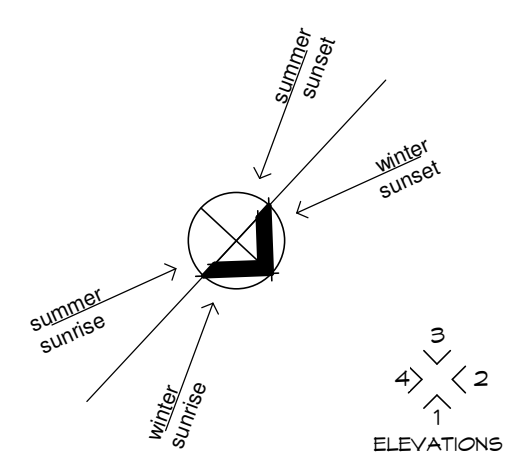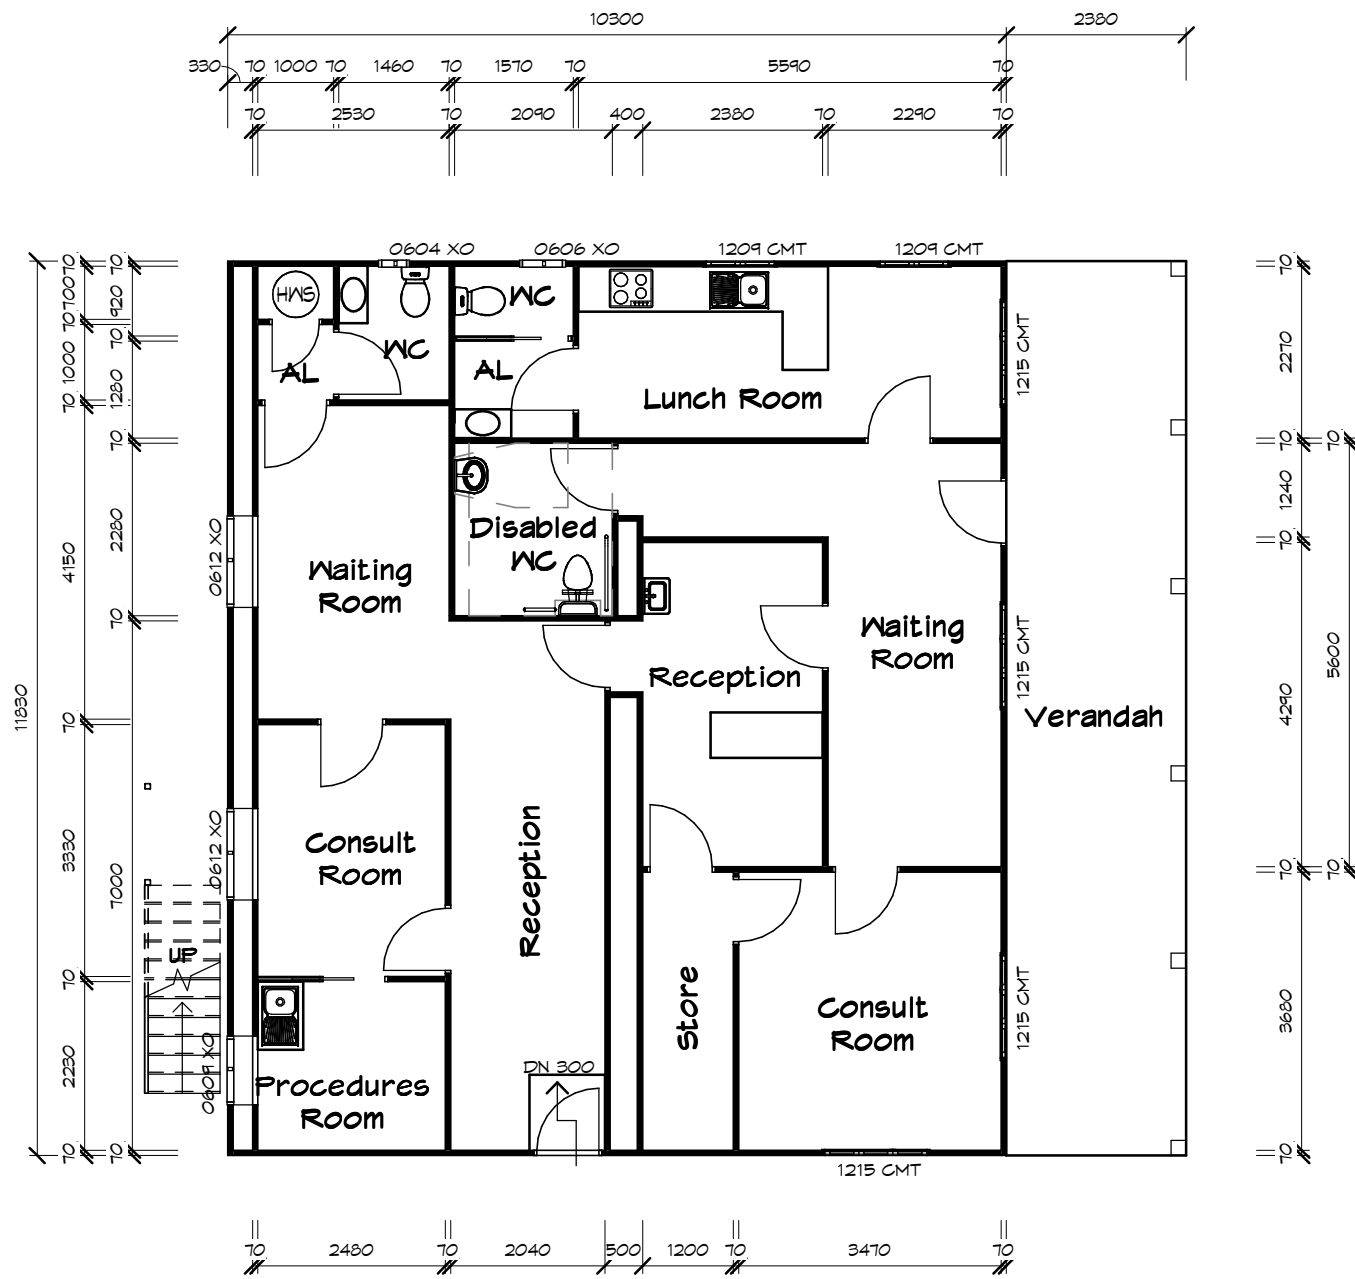

ROCKHAMPTON REGIONAL COUNCIL
AMENDED PLANS APPROVED

19 February 2018

DATE

These plans are approved subject to the current conditions of approval associated with
Development Permit No: D/78-2015

Dated: 13 July 2015

1 Ground Floor Plan
 1 : 100


REVISIONS	No.	DESCRIPTION	DATE
	A	FOR APPROVAL	24/01/18

AS CONSTRUCTED MEDICAL SUITE
 FOR DR. P. ROFE
 AT 67 NORTH STREET,
 ROCKHAMPTON


Rufus Design Group
 STYLE • QUALITY • INNOVATION

MEMBER BUILDING DESIGNERS ASSOC. OF QLD
 Licenced under the QBSA Act
 Lic No. 1180286
 Telephone 61 7 49288011
 Facsimile 61 7 49266579
 E-mail mailbox@rufusdesigngroup.com

PROJECT MANAGER : T.J.R.	WIND SPEED : N/A	PROJECT NUMBER : 171111 - 02
DRAWN : I.L.V.	PLAN SIZE : A3	SHEET 02 OF 03 SHEETS
CHKD : T.J.R.		REVISION : A

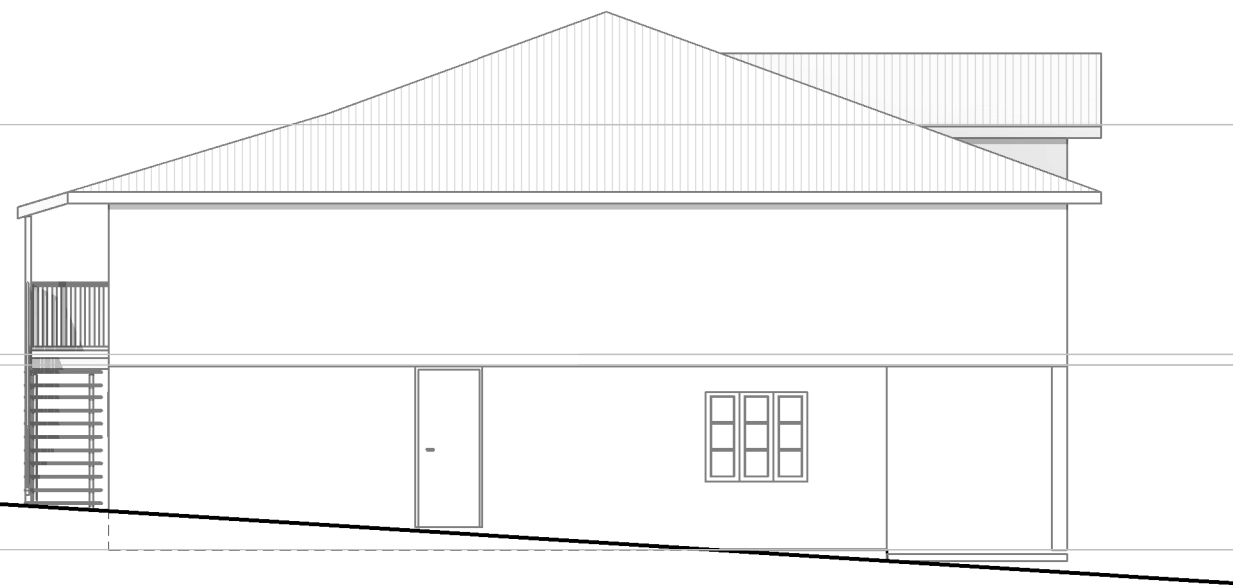


1 Elevation 1
1 : 100

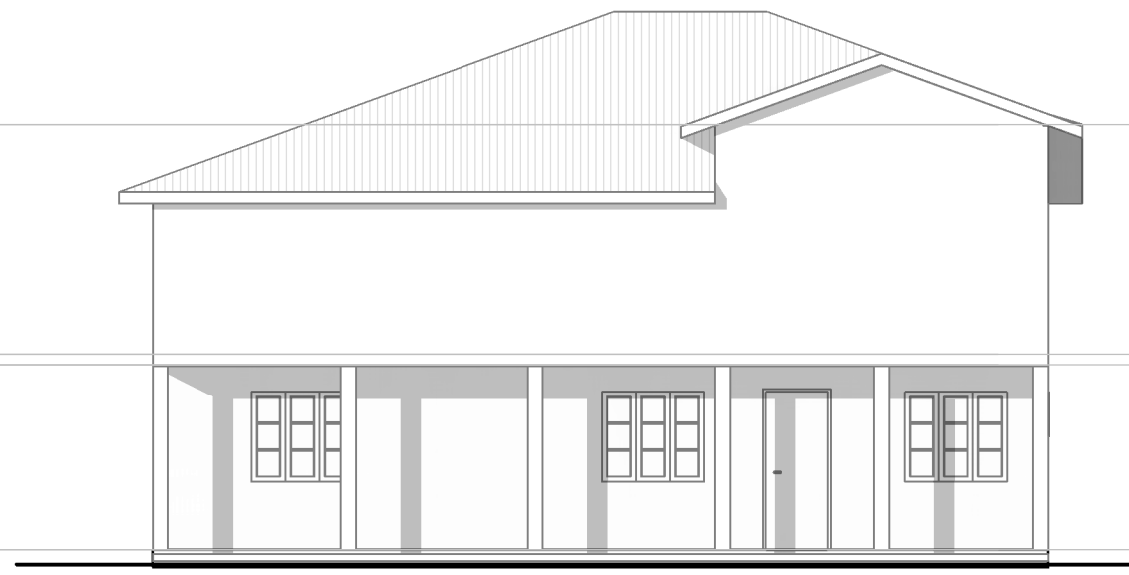

2 Elevation 2
1 : 100

Roof Plate Level 48.310 m
First Floor Level 45.270 m
Ground Floor Top Plate 45.130 m
Ground Floor Level 42.690 m

ROCKHAMPTON REGIONAL COUNCIL
AMENDED PLANS APPROVED
19 February 2018
DATE
These plans are approved subject to the current conditions of approval associated with
Development Permit No: D/78-2015
Dated: 13 July 2015

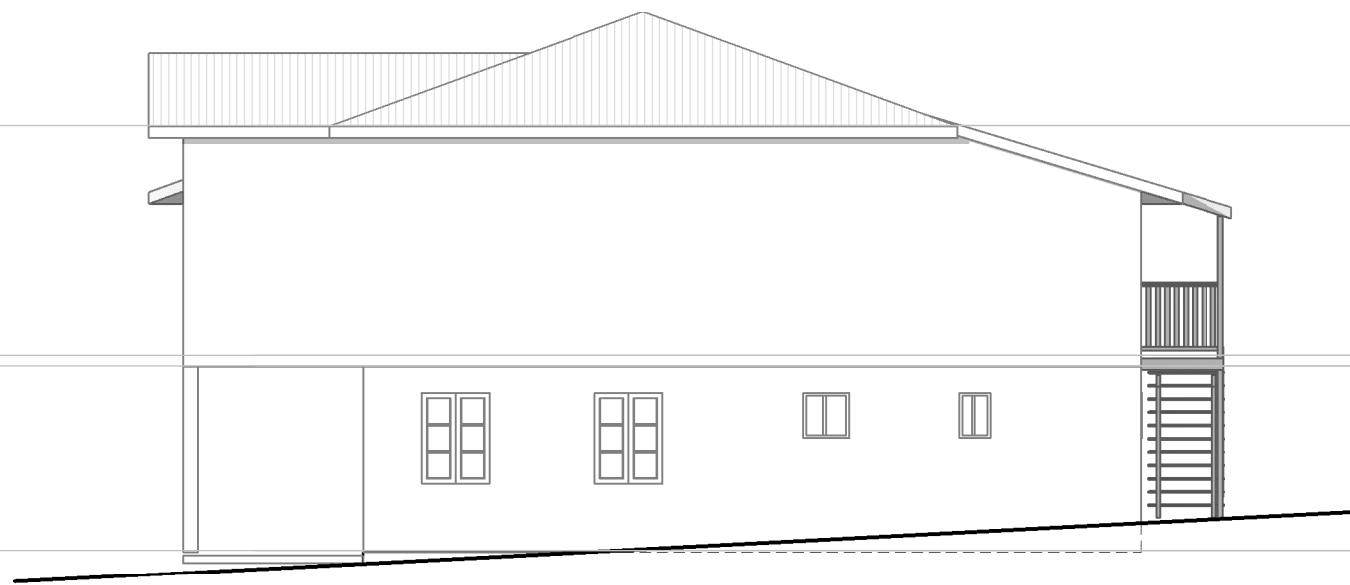

3 Elevation 3
1 : 100



4 Elevation 4
1 : 100

Roof Plate Level 48.310 m
First Floor Level 45.270 m
Ground Floor Top Plate 45.130 m
Ground Floor Level 42.690 m

REVISIONS	No.	DESCRIPTION	DATE
	A	FOR APPROVAL	24/01/18

AS CONSTRUCTED MEDICAL SUITE
FOR DR. P. ROFE
AT 67 NORTH STREET,
ROCKHAMPTON

Rufus Design Group
STYLE • QUALITY • INNOVATION

MEMBER BUILDING DESIGNERS ASSOC. OF QLD
Licenced under the QBSA Act Lic No. 1180286
Telephone 61 7 49288011
Facsimile 61 7 49266579
E-mail mailbox@rufusdesigngroup.com

PROJECT MANAGER : T.J.R.
DRAWN : I.L.V.
CHKD : T.J.R.

WIND SPEED	N/A	PROJECT NUMBER	171111 - 03
PLAN SIZE:	A3	SHEET	03 OF 03 SHEETS
		REVISION	A