



ELEVATION D

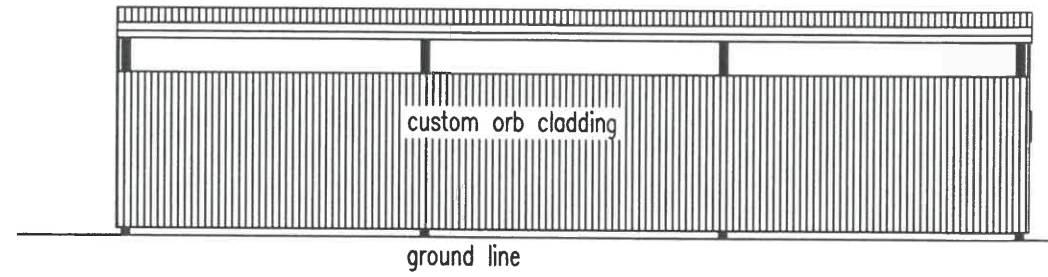


ELEVATION C

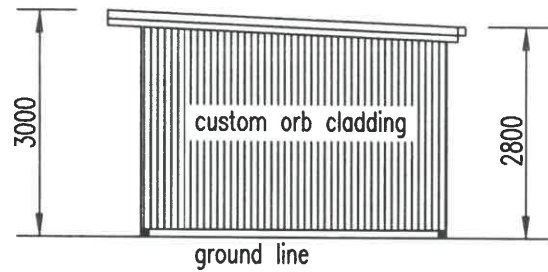


ELEVATION B

ROCKHAMPTON REGIONAL COUNCIL
APPROVED PLANS
These plans are approved subject to the current conditions of approval associated with **Development Permit No.: D/79-2018**
Dated: 10 September 2018

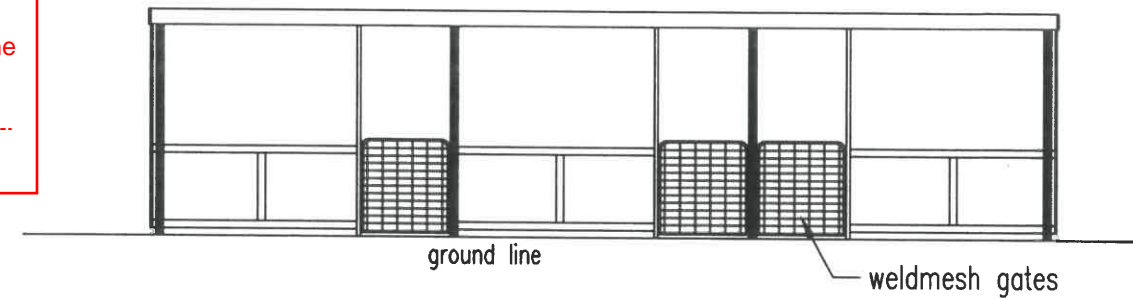


ELEVATION A

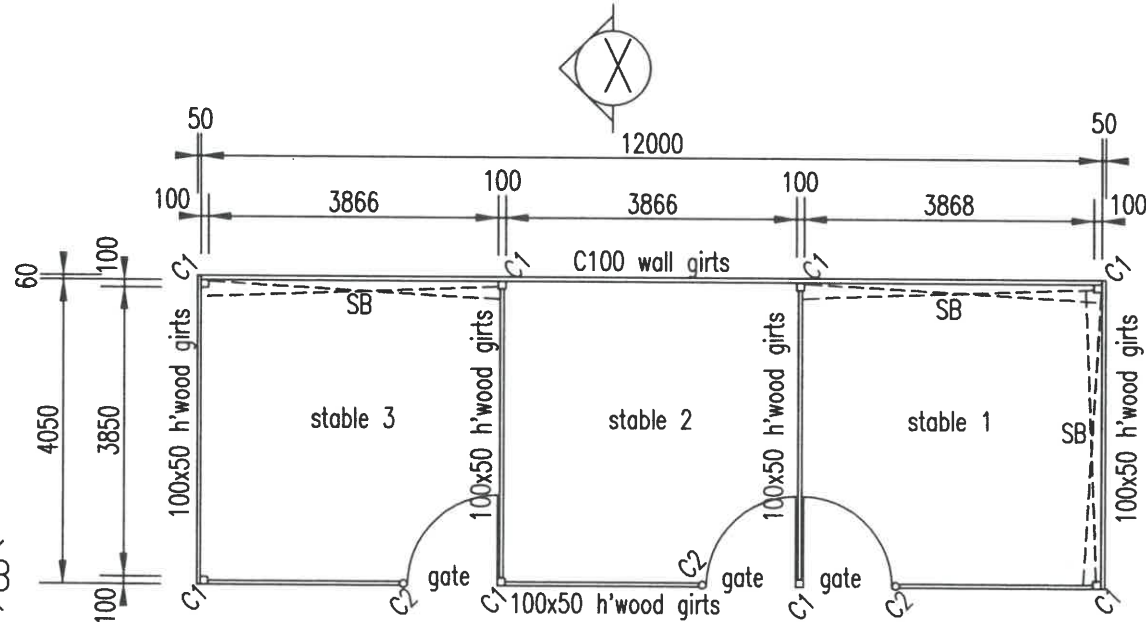


FLOOR PLAN

LEGEND:
C1 100x100 SHS columns
C2 35# CHS columns
SB metal strap bracing

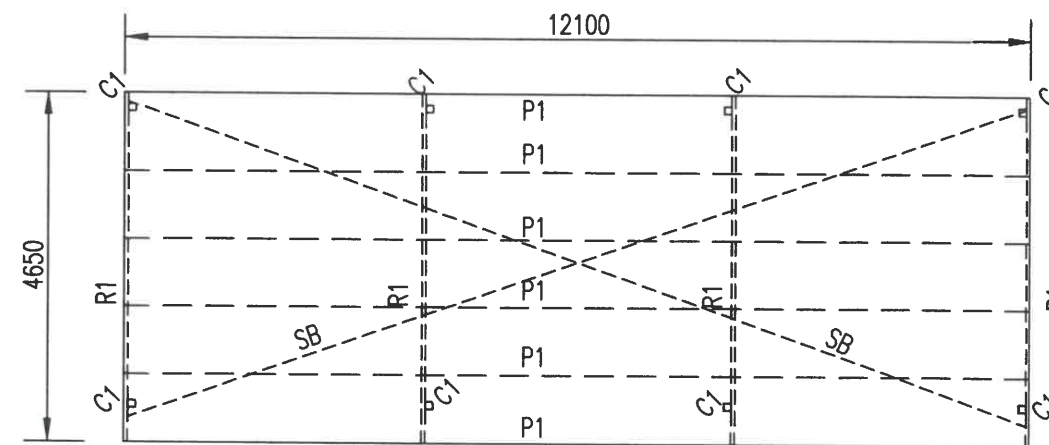


ROOF PLAN

LEGEND:
R1 150x50 H'wood rafters
P1 C100 purlins at 900 centres
SB metal strap bracing on top of purlins

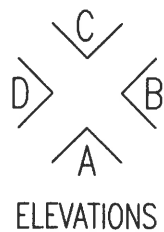

ELEVATIONS

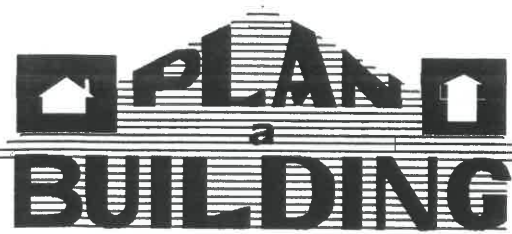

BUILDING DESIGN SERVICE
Des Haughton, A.D.C.E., M.BDAQ, M.QMBA Phone (07) 49264003
ABN 31 412 306 218 Fax 07 49264007 Mobile 0407760733
95 Burnett Street, North Rockhampton 4701


QBSA. Lic. No. 57924

PROJECT AS CONSTRUCTED STABLES
SITE ADDRESS 103 PORT CURTIS ROAD, ROCKHAMPTON
CLIENT K HENSON
CLIENT ADDRESS 103 PORT CURTIS ROAD, ROCKHAMPTON

OWNER K HENSON
OWNERS ADDRESS 103 PORT CURTIS ROAD, ROCKHAMPTON

SCALE:
1:100
16-04-2018

JOB No:
18.22
SHEET 2 OF 4

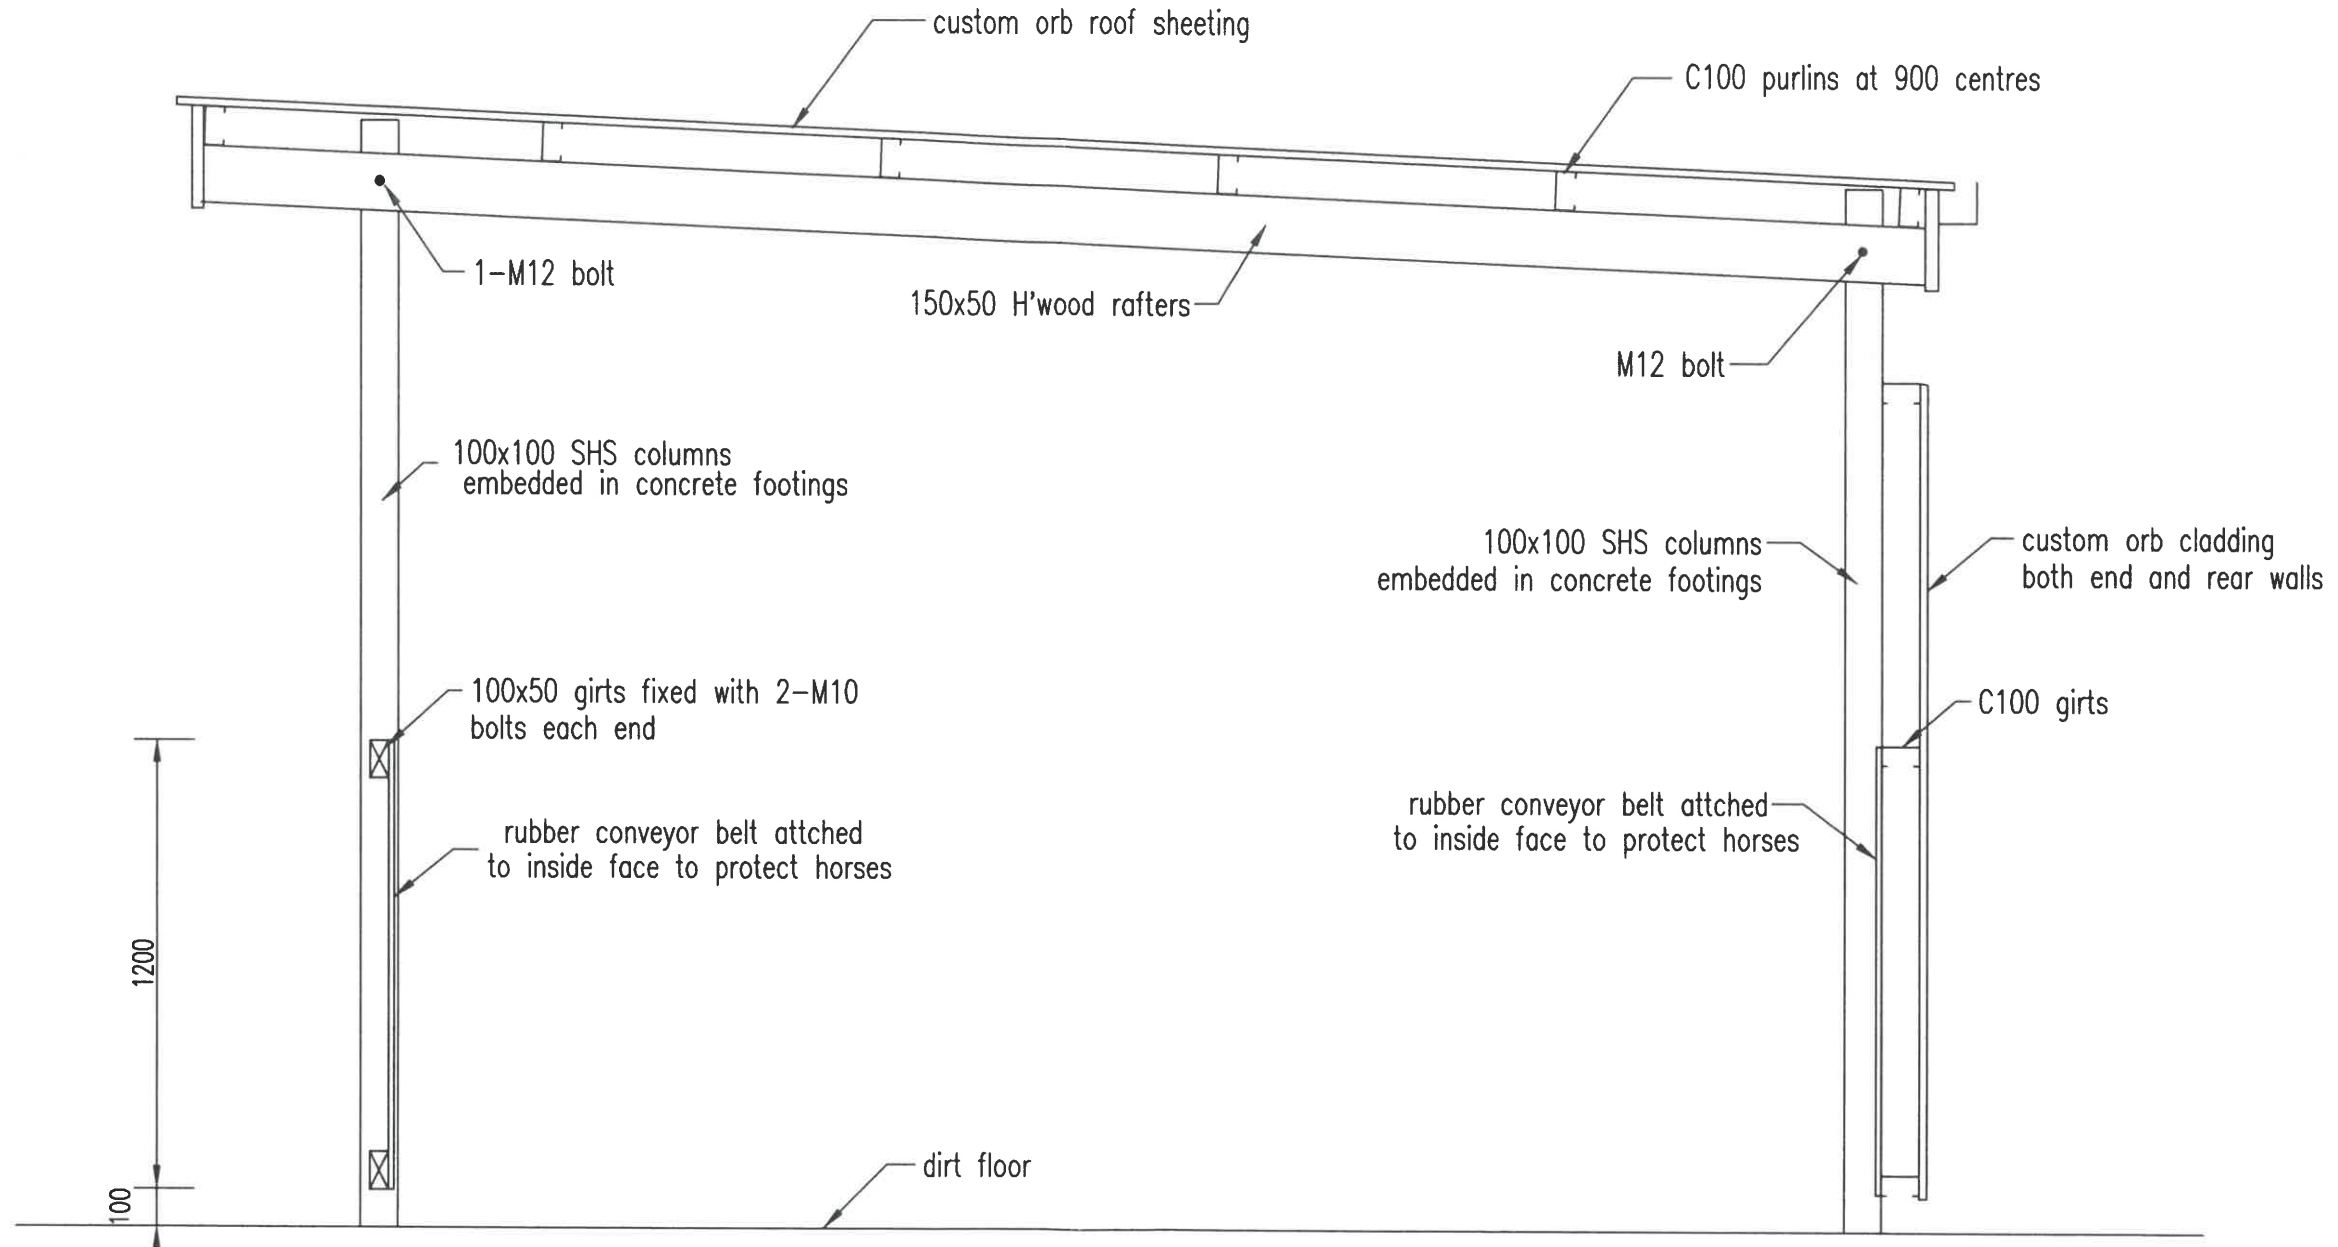

SECTION X - X


ROCKHAMPTON REGIONAL COUNCIL
APPROVED PLANS
These plans are approved subject to the current conditions of approval associated with **Development Permit No.: D/79-2018**
Dated: 10 September 2018

PLAN
BUILDING
BUILDING DESIGN SERVICE
Des Haughton, A.D.C.E., M.BDAQ, M.QMBA Phone (07) 49264003
ABN 31 412 306 218 Fax 07 49264007 Mobile 0407760733
95 Burnett Street, North Rockhampton 4701
QBSA. Lic. No. 57924

PROJECT	AS CONSTRUCTED STABLES	<i>Des Haughton</i>	SCALE:	JOB No:
SITE ADDRESS	103 PORT CURTIS ROAD, ROCKHAMPTON		1: 20	18. 22
CLIENT	K HENSON	OWNER	16-04-2018	SHEET 3 OF 4
CLIENT ADDRESS	103 PORT CURTIS ROAD, ROCKHAMPTON	OWNERS ADDRESS		




building designers
association of
queensland

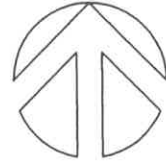

PROPERTY DESCRIPTION

LOT NUMBER: 1, 5 & 6
REGISTERED PLAN NUMBER: 601027
PARISH: ROCKHAMPTON
COUNTY: LIVINGSTONE
AREA: 4131.9 SQ.METRES TOTAL

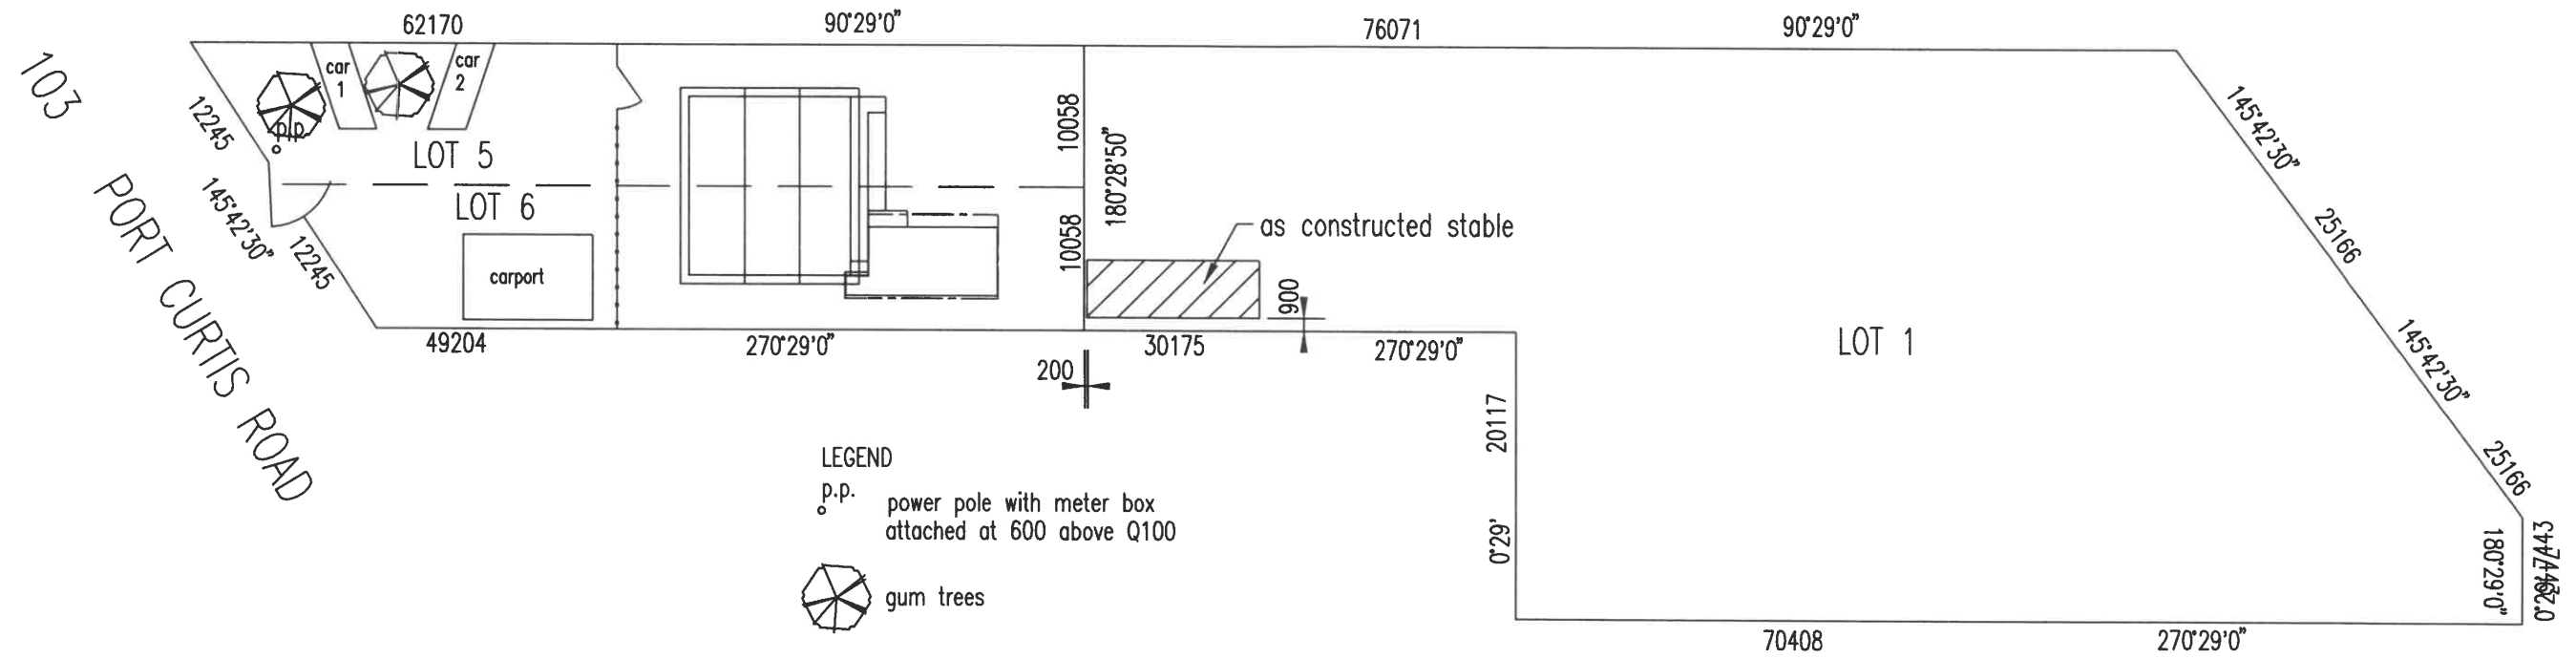

- LEGEND
- p.p. power pole with meter box attached at 600 above Q100
 - gum trees

SITE PLAN

ROCKHAMPTON REGIONAL COUNCIL

APPROVED PLANS

These plans are approved subject to the current conditions of approval associated with

Development Permit No.: D/79-2018

Dated: 10 September 2018

PLAN
a
BUILDING

BUILDING DESIGN SERVICE
Des Houghton, A.D.C.E., M.BDAQ, M.QMBA Phone (07) 49264003
ABN 31 412 306 218 Fax 07 49264007 Mobile 0407760733
95 Burnett Street, North Rockhampton 4701
QBSA. Lic. No. 57924

PROJECT	AS CONSTRUCTED STABLES		SCALE:	JOB No:
SITE ADDRESS	103 PORT CURTIS ROAD, ROCKHAMPTON		1: 500	18. 22
CLIENT	K HENSON	OWNER	16-04-2018	SHEET 4 OF 4
CLIENT ADDRESS	103 PORT CURTIS ROAD, ROCKHAMPTON	OWNERS ADDRESS		