



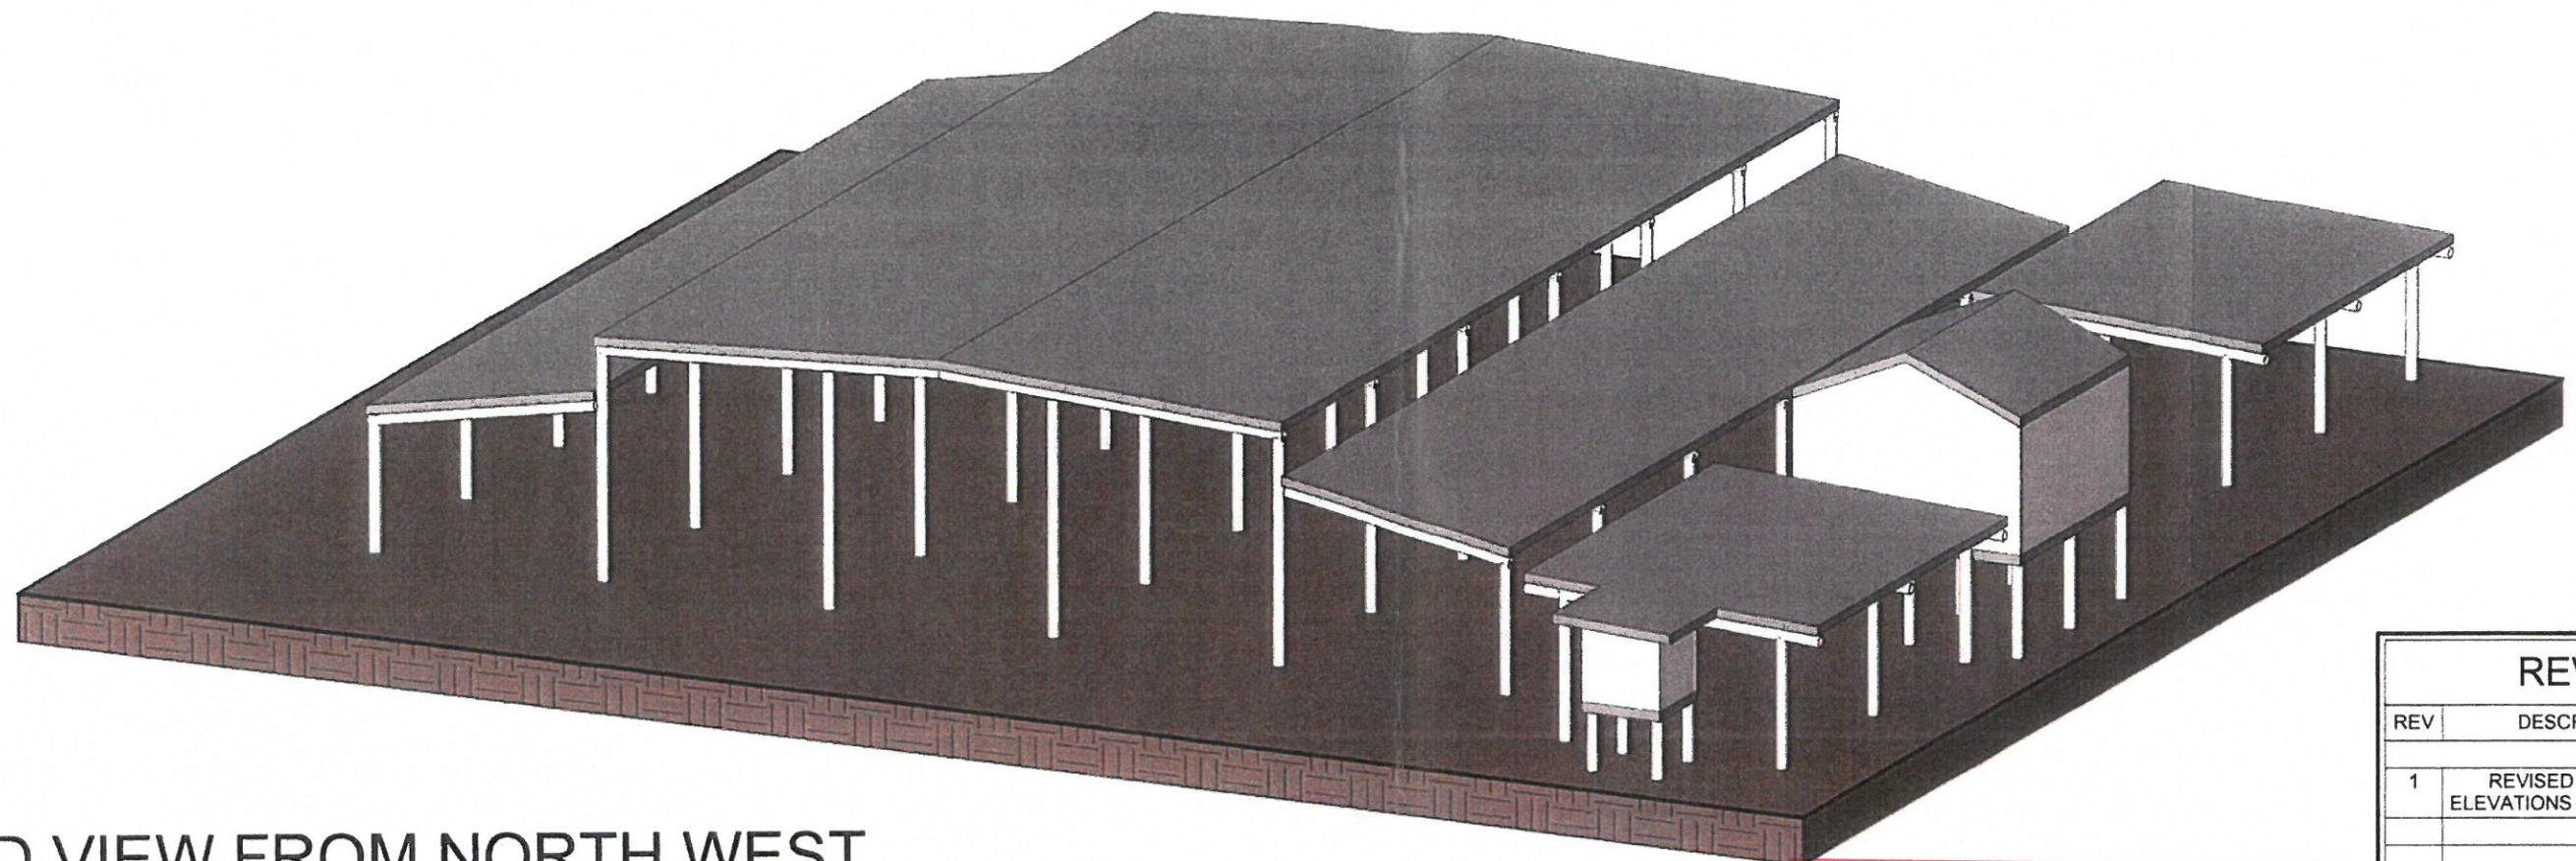

3D VIEW FROM NORTH WEST

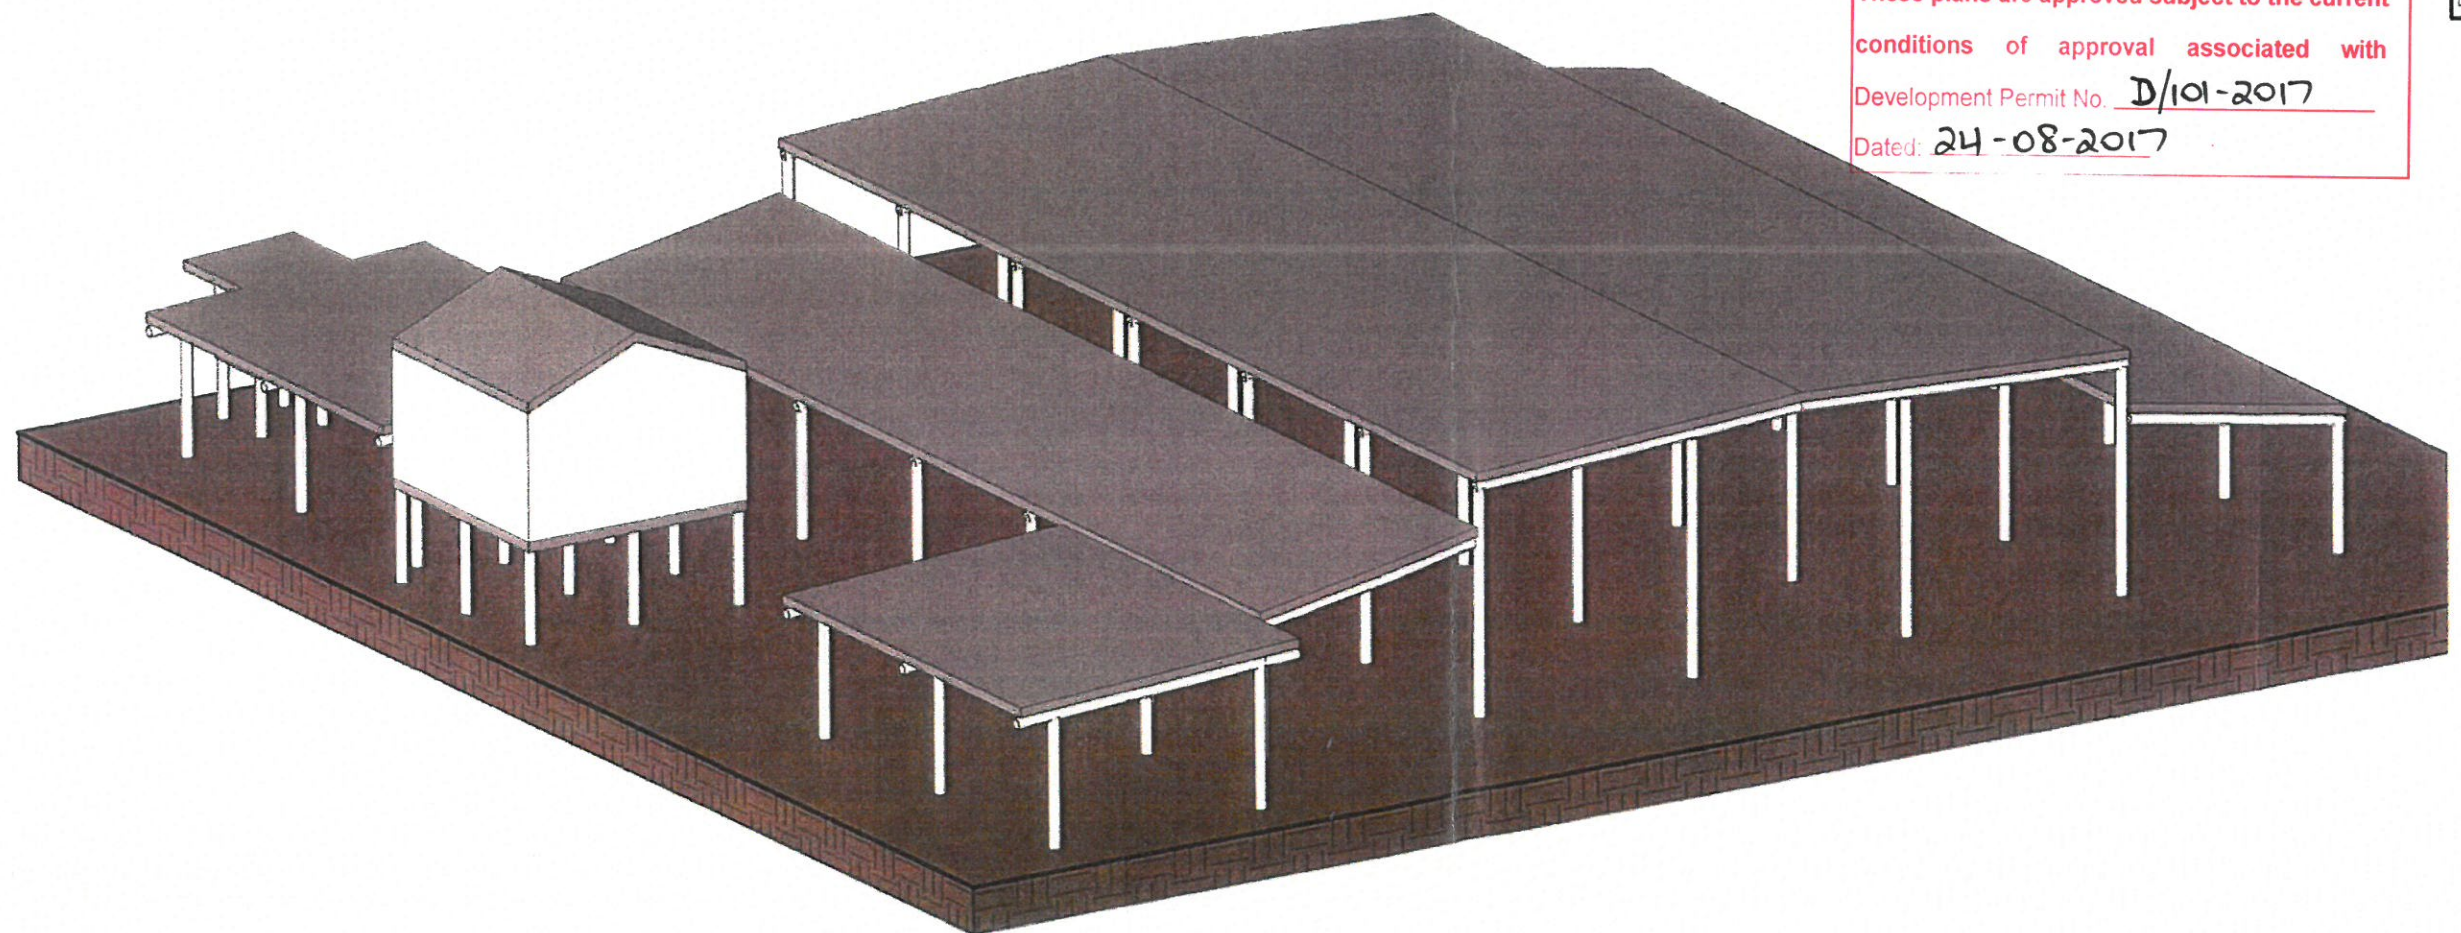

3D VIEW FROM SOUTH WEST

ROCKHAMPTON REGIONAL COUNCIL
 These plans are approved subject to the current
 conditions of approval associated with
 Development Permit No. D/101-2017
 Dated: 24-08-2017

REVISION		
REV	DESCRIPTION	DATE
1	REVISED SITE PLAN ELEVATIONS AND 3D VIEWS	08/07/2017

project:
**AS CONSTRUCTED NURSERY
 AT 6 GOODSALL STREET, THE
 COMMON QLD 470**

client:
DOMINIC DOBLO


 Shop 5/10 Denham St
 Rockhampton
 QLD, 4700
 p 0749 222880
 building design - documentation



 QBCC MEM. NO # 1123040

 BDAQ MEM. NO # 0000761

title:
3D VIEWS


scale:	project no: 1707-02	
sheet no:	drawing no	rev:
drawn: kdt	WD-03	1

8/07/2017 1:05:25 PM

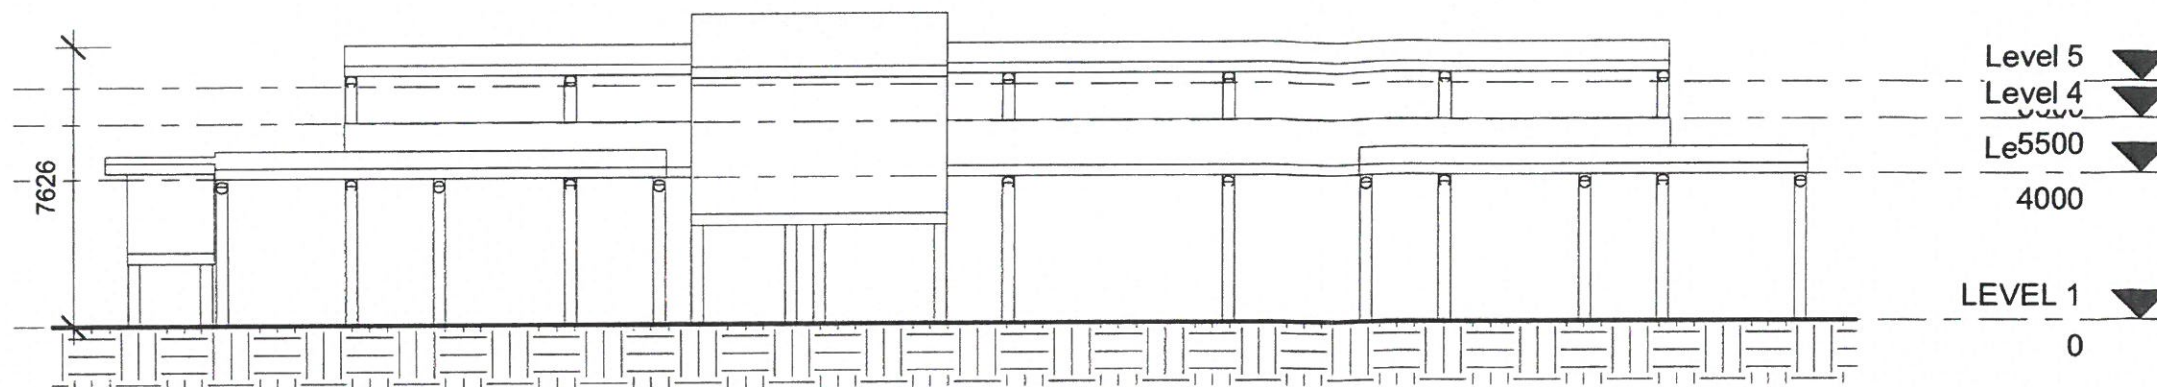


Elevation 1

1 : 200

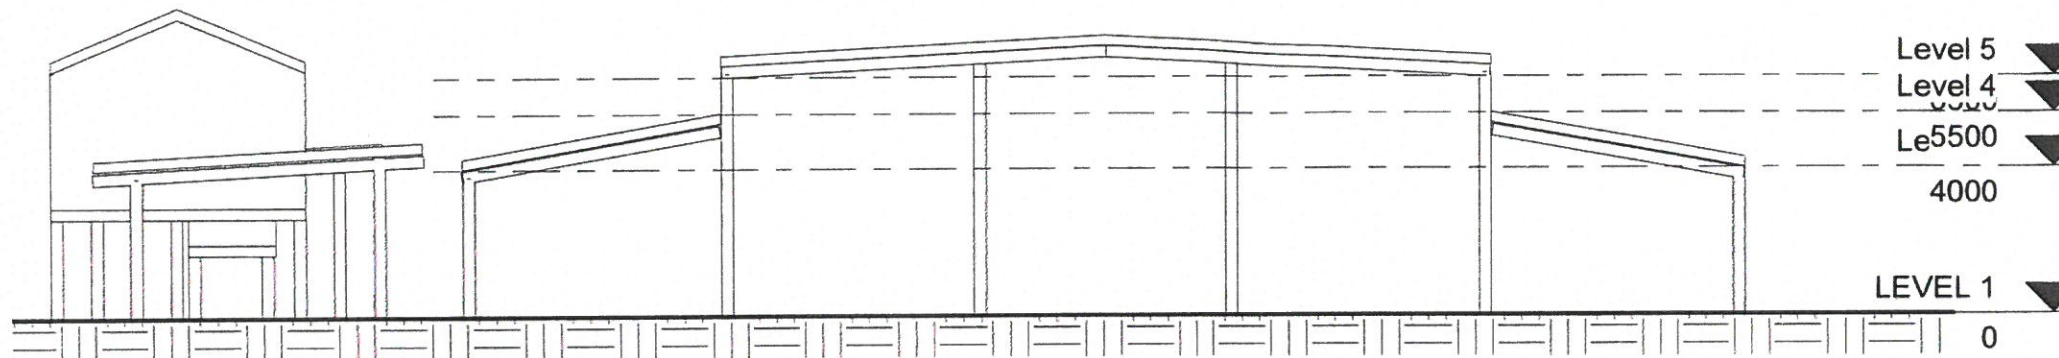


Elevation 2

1 : 200

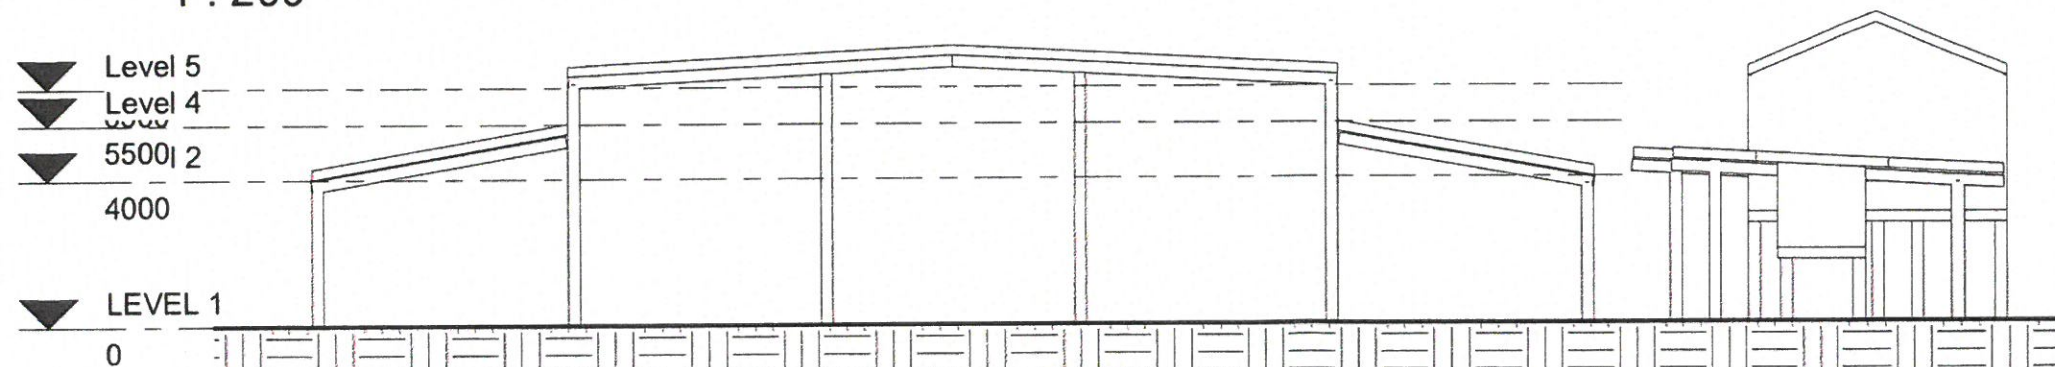

Elevation 3

1 : 200

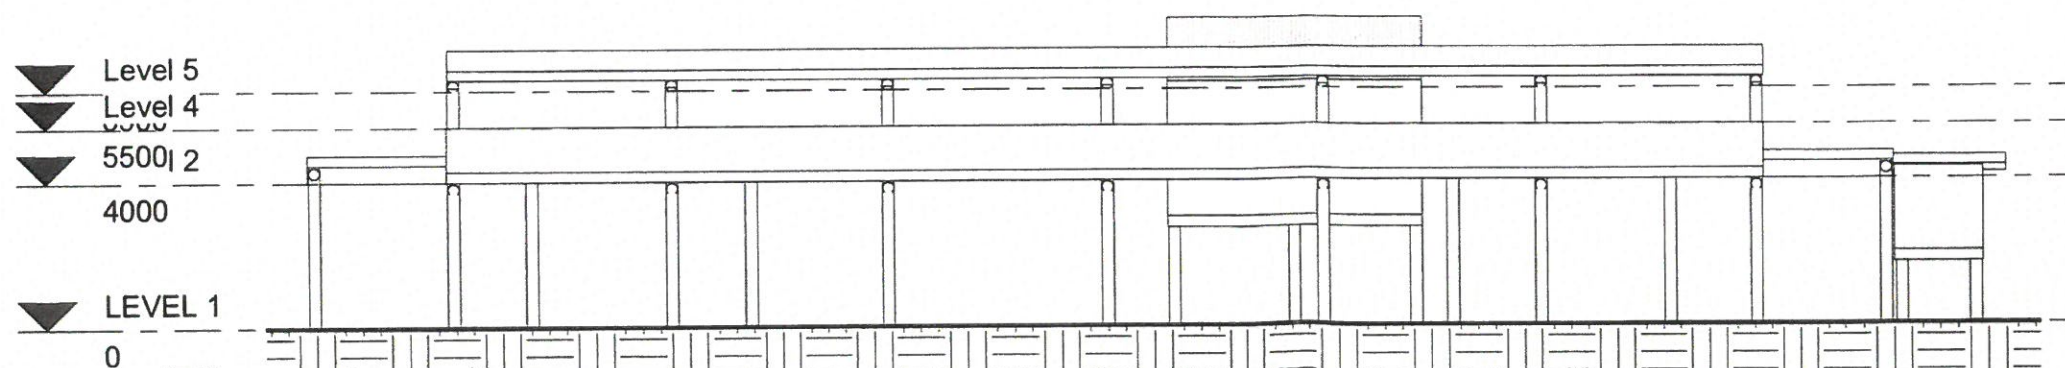

Elevation 4

1 : 200

REVISION		
REV	DESCRIPTION	DATE
1	REVISED SITE PLAN ELEVATIONS AND 3D VIEWS	08/07/2017


ROCKHAMPTON REGIONAL COUNCIL

These plans are approved subject to the current conditions of approval associated with Development Permit No. D/101-2017

Dated: 24-08-2017



project: AS CONSTRUCTED NURSERY AT 6 GOODSALL STREET, THE COMMON QLD 470	
client: DOMINIC DOBLO	
 Shop 5/10 Denham St Rockhampton QLD, 4700 p 0749 222880 building design - documentation	
 QBCC MEM. NO # 1123040 BDAQ MEM. NO # 0000761	
title: ELEVATIONS	
scale: 1 : 200	project no: 1707-02
sheet no:	drawing no: WD-02 rev: 1
drawn: kdt	

8/07/2017 1:05:23 PM

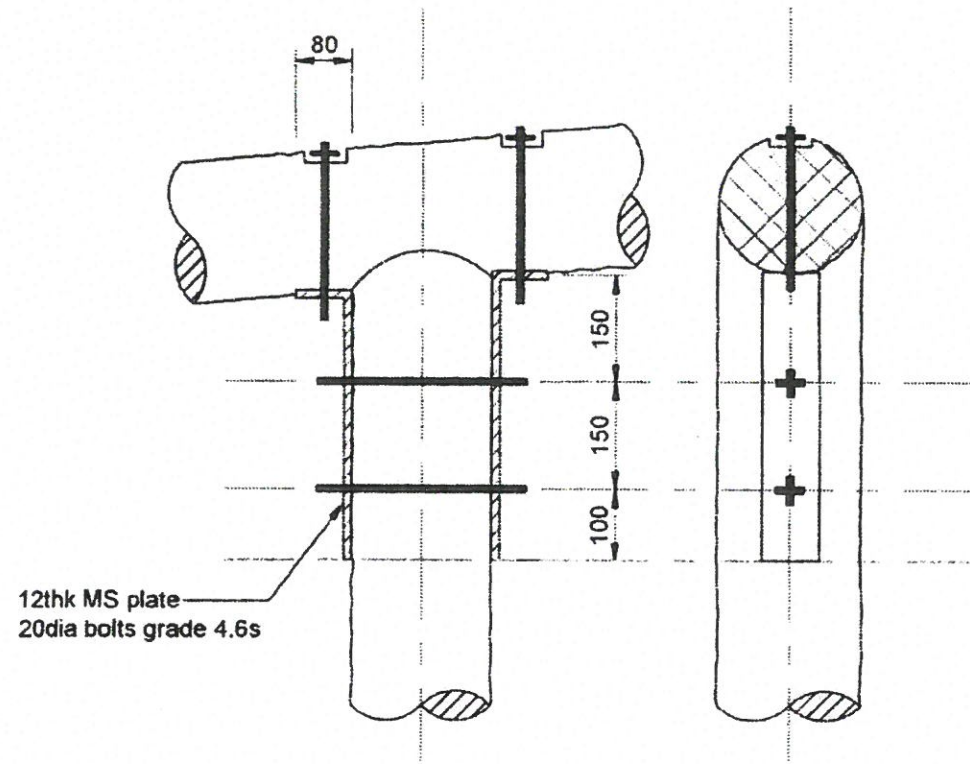

DETAIL 10
Scale 1:10

SIMILAR 11
Scale 1:10

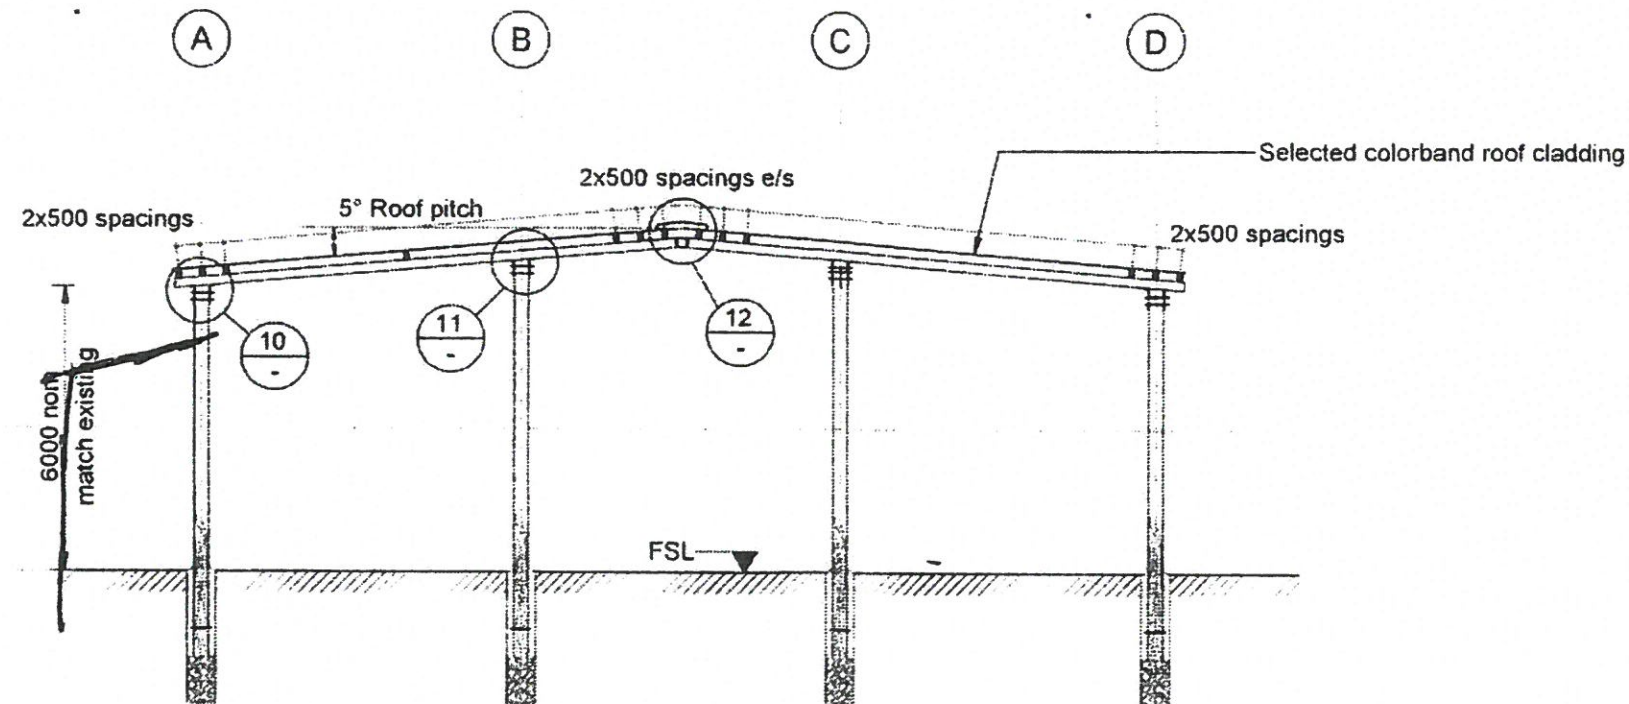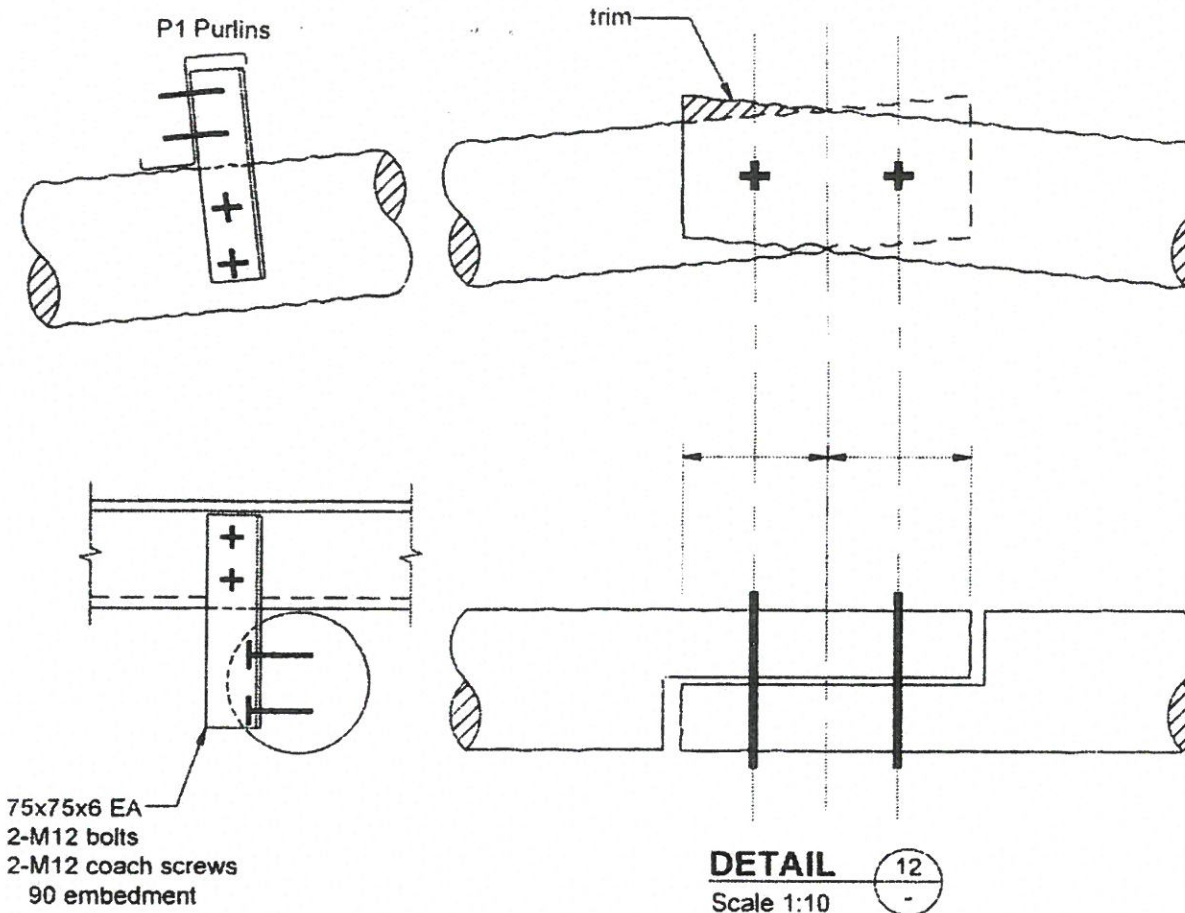

ROCKHAMPTON REGIONAL COUNCIL

These plans are approved subject to the current conditions of approval associated with Development Permit No. D/101-2017
Dated: 24-08-2017

08/08/17	A	FOR APPROVAL
DATE	REV.	NOTES
APPROVED		
CHECKED	JMT	
DRAWN		
DESIGN	JMT	
TAPSELL CONSULTING ENGINEERS PTY LTD A.B.N. N.o. 78 065 154 949 14 MILFORD AVENUE, NORTH ROCKHAMPTON, 4701 TELEPHONE: 07 4926 3554 email: jtapsell@bigpond.net.au		

PROJECT
REPAIR EXISTING SHED

FOR
HUDCO Pty Ltd T/A
ATF HUDCO SUPER FUND

AT
6 GOODSALL STREET
NORTH ROCKHAMPTON

JOB No.	0417-42	
REV.	A	SHEET 4 of 4

REAL PROPERTY DESCRIPTION

LOT 1 ON RP618797
LOCAL AUTHORITY: ROCKHAMPTON REGIONAL
SITE AREA 5,157m²

REVISION

REV	DESCRIPTION	DATE
1	AS CONSTRUCTED SITE PLAN	06/07/2017
2	REVISED SITE PLAN ELEVATIONS AND 3D VIEWS	08/07/2017
3	REVISED SITE PLAN ELEVATIONS AND 3D VIEWS 02	18/07/2017

COLOUR

PLEASE NOTE. DRAWINGS
PRODUCED IN COLOUR.
NON-COLOUR COPIES MAY
REDUCE INFORMATION,
DETAIL & CLARITY.

A3 DRAWING

NOTED SCALES RELATE
TO A3 DRAWINGS

project:
**AS CONSTRUCTED NURSERY
AT 6 GOODSALL STREET, THE
COMMON QLD 470**

client:
DOMINIC DOBLO

 Shop 5/10 Denham St
Rockhampton
QLD, 4700
p 0749 222880
building design - documentation


 QBCC MEM. NO # 1123040
BDAQ MEM. NO # 0000761 

title:
**AS CONSTRUCTED SITE
PLAN**

scale: 1 : 500	project no: 1707-02
sheet no: 1 OF 1	drawing no: WD-01
drawn:	rev: 3

18/07/2017 3:20:10 PM

GOODSALL STREET

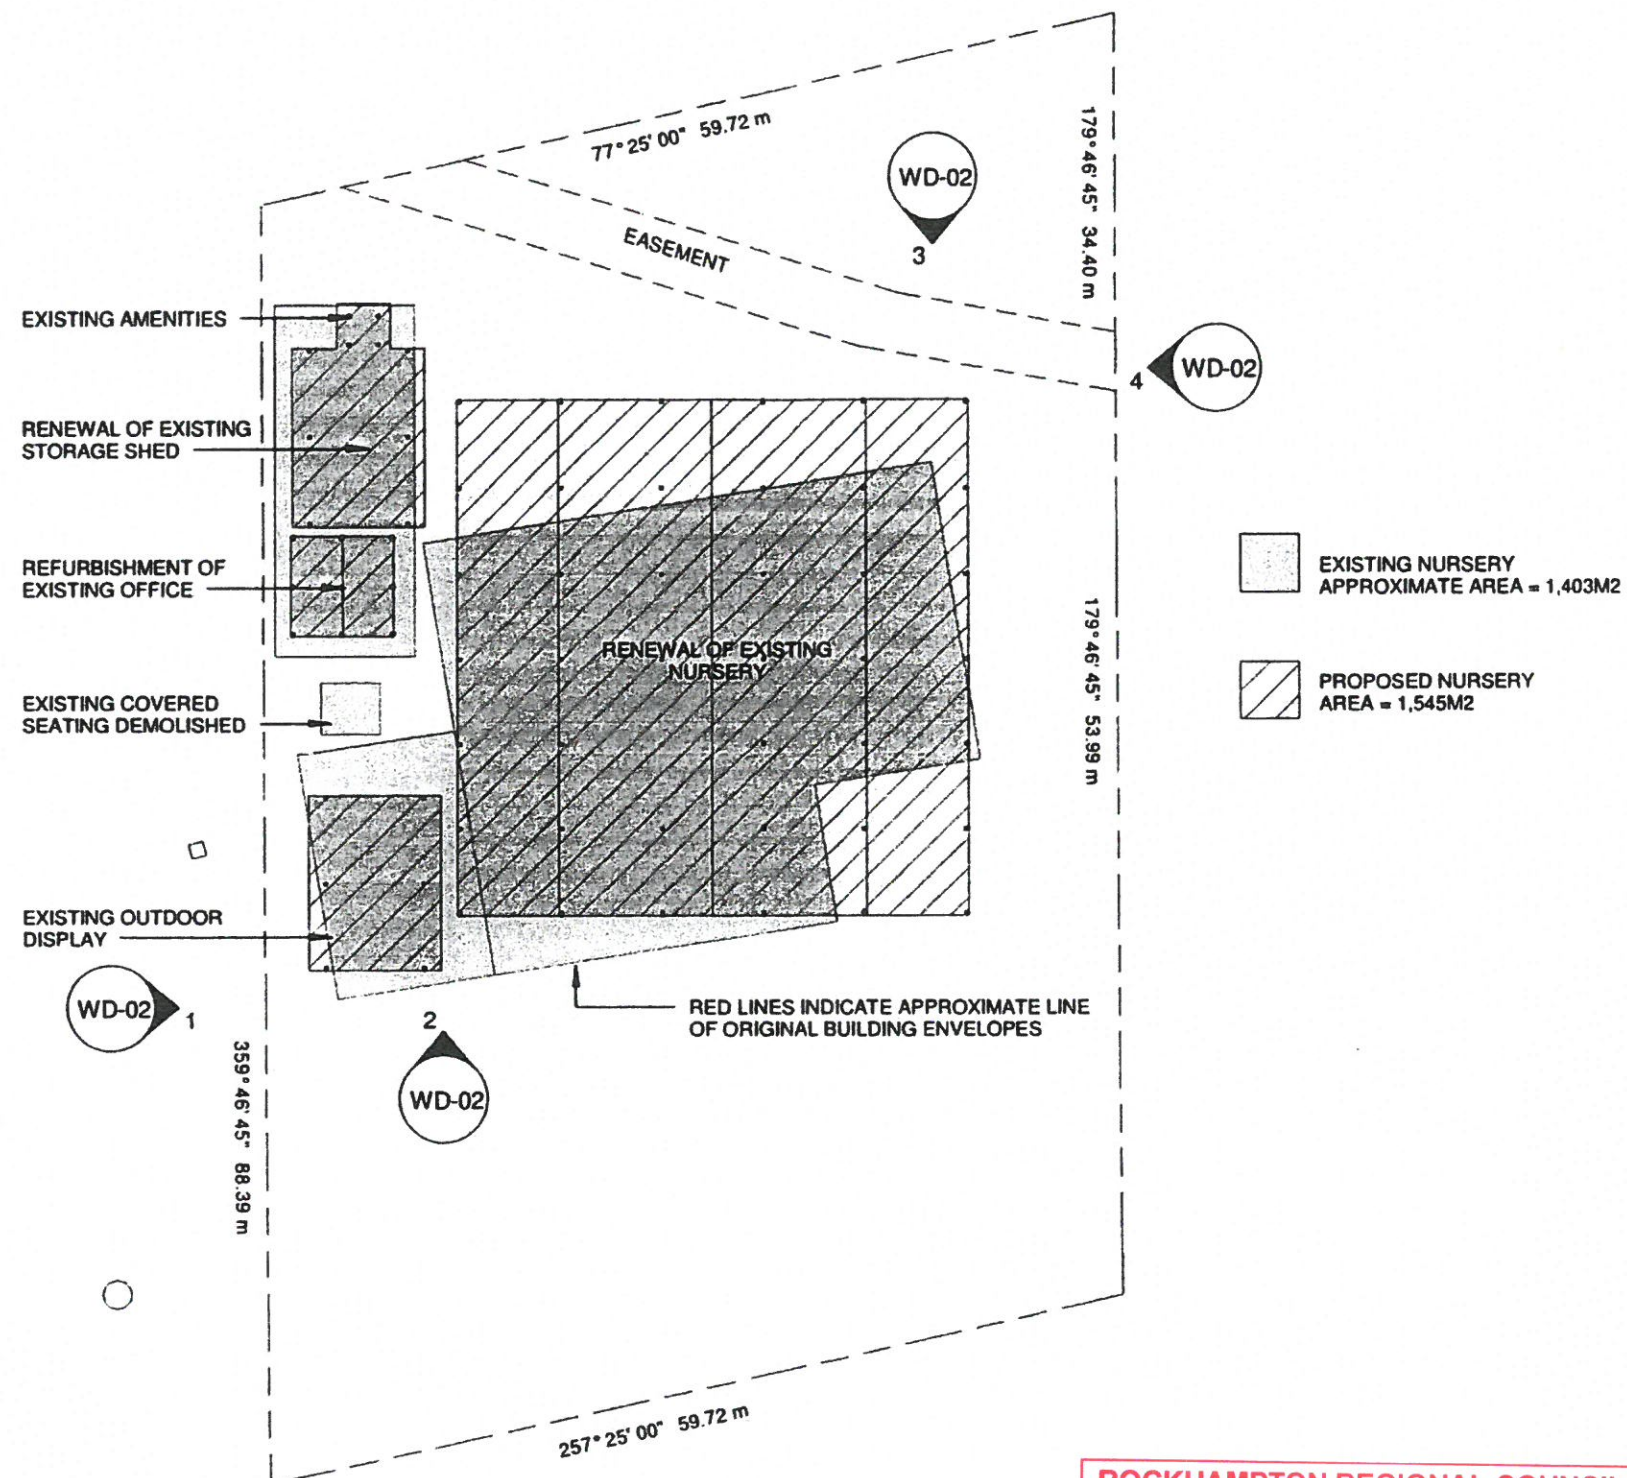

SITE PLAN

1 : 500



ROCKHAMPTON REGIONAL COUNCIL

These plans are approved subject to the current
conditions of approval associated with
Development Permit No. D/101-2017
Dated: 24-08-2017