



DETAIL SITE PLAN

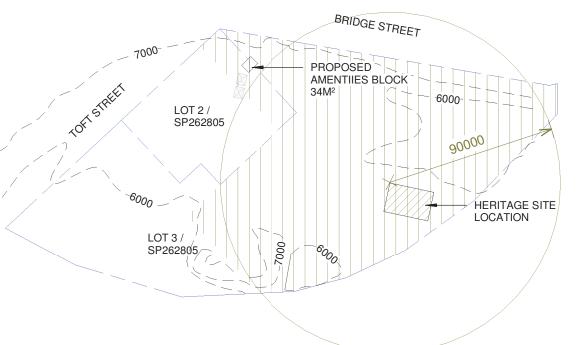

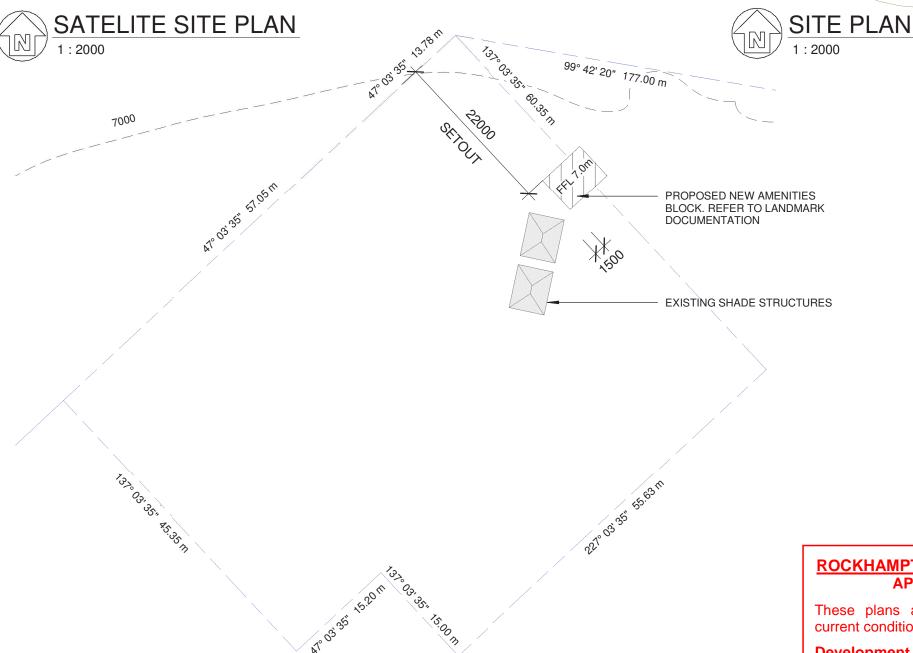

ROCKHAMPTON REGIONAL COUNCIL APPROVED PLANS

These plans are approved subject to the current conditions of approval associated with

Development Permit No: D/11-2018

Dated: 27 February 2018

	REVISION	
REV	DESCRIPTION	DATE
Α	PROPOSED SITE PLAN	08/01/2018

COLOUR

PLEASE NOTE. DRAWINGS PRODUCED IN COLOUR. NON-COLOUR COPIES MAY REDUCE INFORMATION, DETAIL & CLARITY.

A3 DRAWING

NOTED SCALES RELATE TO A3 DRAWINGS

REAL PROPERTY DESCRIPTION

LOT 2 / 3 ON SP262805 LOCAL GOVERNMENT ROCKHAMPTION **REGIONAL** SITE AREA LOT 2 - 4,047M²

LOT 3 - 3.122ha

project:

PROPOSED AMENITIES BLOCK FOR RRC AT 16-20 BRIDGE STREET, **BERSERKER QLD 4701**

client:

ROCKHAMPTON REGIONAL COUNCIL



Shop 5/10 Denham St Rockhampton QLD, 4700


building design - documentation




QBCC MEM. NO # 1123040 DCC BDAQ MEM. NO # 0000761

title: PROPOSED SITE PLAN

scale: As indicated project no: 1712-02 sheet no: 01 OF 01 drawing no rev: වි drawn: MD DA-01

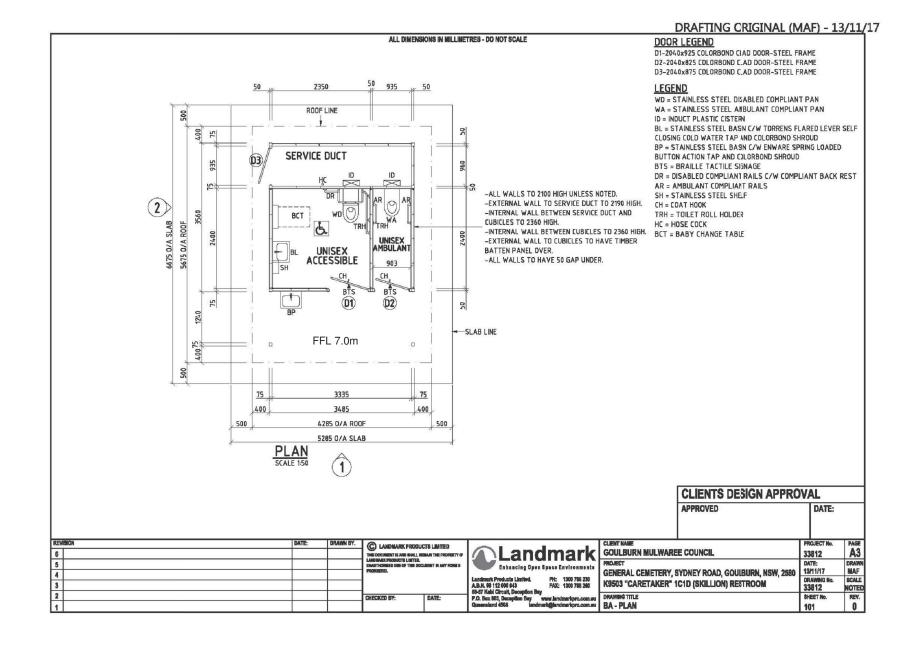

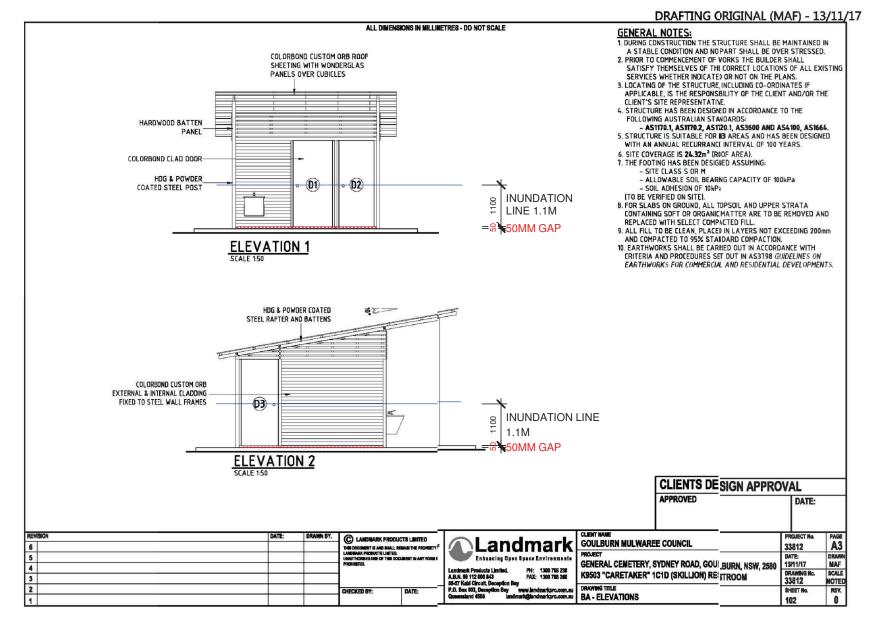

COPYRIGHT AS PER LANDMARK. MARKED UP FOR PURPOSES OF RRC PLANNING REQUIREMENTS ONLY,

ROCKHAMPTON REGIONAL COUNCIL APPROVED PLANS

These plans are approved subject to the current conditions of approval associated with

Development Permit No: D/11-2018

Dated: 27 February 2018

project:
PROPOSED AMENITIES
BLOCK FOR RRC AT 16-20
BRIDGE STREET,
BERSERKER QLD 4701

client:

ROCKHAMPTON REGIONAL COUNCIL



QBCC MEM. NO # 1123040


OCC BDAQ MEM. NO # 0000761

title: INUNDATION LEVEL

scale: 1:100 project no:

sheet no: 02 of 02 drawn: 1712-02 drawing no rev DA-02

ALL DIMENSIONS IN MILLIMETRES - DO NOT SCALE

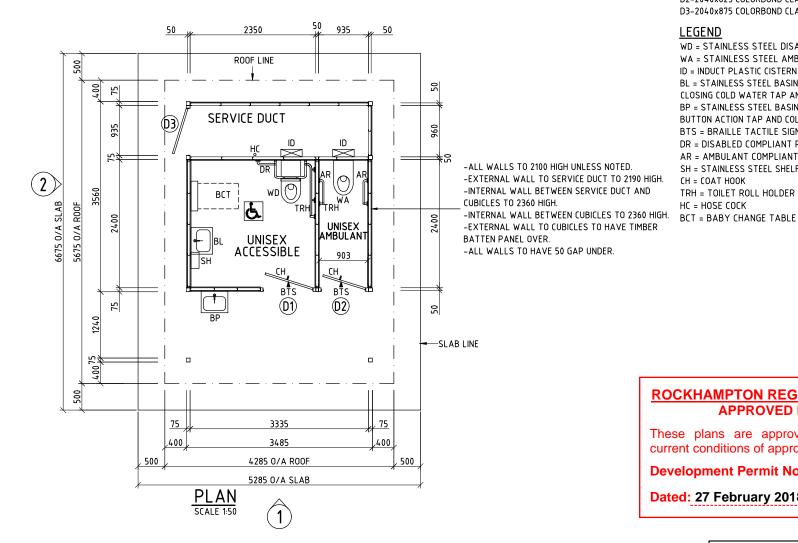

DOOR LEGEND

D1-2040x925 COLORBOND CLAD DOOR-STEEL FRAME D2-2040x825 COLORBOND CLAD DOOR-STEEL FRAME D3-2040x875 COLORBOND CLAD DOOR-STEEL FRAME

LEGEND

WD = STAINLESS STEEL DISABLED COMPLIANT PAN WA = STAINLESS STEEL AMBULANT COMPLIANT PAN

ID = INDUCT PLASTIC CISTERN

BL = STAINLESS STEEL BASIN C/W TORRENS FLARED LEVER SELF CLOSING COLD WATER TAP AND COLORBOND SHROUD BP = STAINLESS STEEL BASIN C/W ENWARE SPRING LOADED

BUTTON ACTION TAP AND COLORBOND SHROUD

BTS = BRAILLE TACTILE SIGNAGE

DR = DISABLED COMPLIANT RAILS C/W COMPLIANT BACK REST

AR = AMBULANT COMPLIANT RAILS

SH = STAINLESS STEEL SHELF

CH = COAT HOOK

TRH = TOILET ROLL HOLDER

HC = HOSE COCK

ROCKHAMPTON REGIONAL COUNCIL APPROVED PLANS

These plans are approved subject to the current conditions of approval associated with

Development Permit No: D/11-2018

Dated: 27 February 2018

CLIENTS DESIGN APPROVAL APPROVED DATE:

REVISION		DATE:	DRAWN BY.	C LANDMARK PRODUC	CTS LIMITED	
6				THIS DOCUMENT IS AND SHALL REMAIN THE PROPERTY LANDMARK PRODUCTS LIMITED. UNAUTHORISED USE OF THIS DOCUMENT IN ANY FORM I PROHIBITED.		
5						
4						
3						
2				CHECKED BY:	DATE:	
1						

Landmark


Landmark Products Limited. A.B.N. 99 112 000 843 55-57 Kabi Circuit, Deception Bay P.O. Box 603, Deception Bay www.landmarkpro.com.au


Queensland 4508

PH: 1300 768 230 FAX: 1300 768 260 landmark@landmarkpro.com.au

CLIENT NAME			OJECT No.	PAGE
GOULBURN MULWAREE COUNCIL			812	A3
PROJECT GENERAL CEMETERY, SYDNEY ROAD, GOULBURN, NSW, 2580 K9503 "CARETAKER" 1C1D (SKILLION) RESTROOM			TE:	DRAW
			/11/17	MAF
			AWING No. 8812	SCALE NOTE
DRAWING TITLE		SH	EET No.	REV.
BA - PLAN)1	10

ALL DIMENSIONS IN MILLIMETRES - DO NOT SCALE

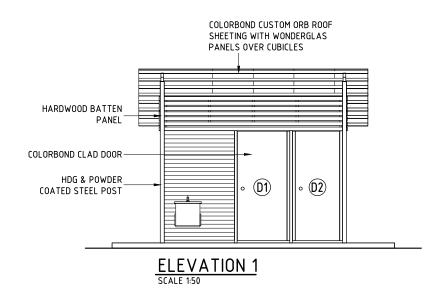

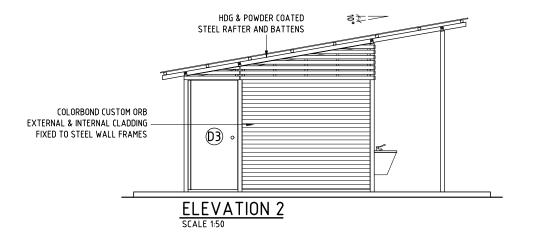

GENERAL NOTES:

- 1. DURING CONSTRUCTION THE STRUCTURE SHALL BE MAINTAINED IN A STABLE CONDITION AND NO PART SHALL BE OVER STRESSED.
- 2. PRIOR TO COMMENCEMENT OF WORKS THE BUILDER SHALL SATISFY THEMSELVES OF THE CORRECT LOCATIONS OF ALL EXISTING SERVICES WHETHER INDICATED OR NOT ON THE PLANS.
- 3. LOCATING OF THE STRUCTURE, INCLUDING CO-ORDINATES IF APPLICABLE, IS THE RESPONSIBILITY OF THE CLIENT AND/OR THE CLIENT'S SITE REPRESENTATIVE.
- 4. STRUCTURE HAS BEEN DESIGNED IN ACCORDANCE TO THE FOLLOWING AUSTRALIAN STANDARDS:
 - AS1170.1, AS1170.2, AS1720.1, AS3600 AND AS4100, AS1664.
- 5. STRUCTURE IS SUITABLE FOR N3 AREAS AND HAS BEEN DESIGNED WITH AN ANNUAL RECURRANCE INTERVAL OF 100 YEARS.
- 6. SITE COVERAGE IS 24.32m2 (ROOF AREA).
- 7. THE FOOTING HAS BEEN DESIGNED ASSUMING:
 - SITE CLASS S OR M
 - ALLOWABLE SOIL BEARING CAPACITY OF 100kPa
 - SOIL ADHESION OF 10kPa

(TO BE VERIFIED ON SITE).

- 8. FOR SLABS ON GROUND, ALL TOPSOIL AND UPPER STRATA CONTAINING SOFT OR ORGANIC MATTER ARE TO BE REMOVED AND REPLACED WITH SELECT COMPACTED FILL.
- 9. ALL FILL TO BE CLEAN, PLACED IN LAYERS NOT EXCEEDING 200mm AND COMPACTED TO 95% STANDARD COMPACTION.
- 10. EARTHWORKS SHALL BE CARRIED OUT IN ACCORDANCE WITH CRITERIA AND PROCEDURES SET OUT IN AS3798 GUIDELINES ON EARTHWORKS FOR COMMERCIAL AND RESIDENTIAL DEVELOPMENTS.

ROCKHAMPTON REGIONAL COUNCIL APPROVED PLANS

These plans are approved subject to the current conditions of approval associated with

Development Permit No: D/11-2018

Dated: 27 February 2018

CLIENTS DESIGN APPROVAL				
APPROVED	DATE:			

REV	ISION	DATE:	DRAWN BY.	C LANDMARK PRODUCTS LIMITED THIS DOCUMENT IS AND SHALL REMAIN THE PROPERTY LANDMARK PRODUCTS LIMITED. UNAUTHORISED USE OF THIS DOCUMENT IN ANY FORM IP PROMBITED.		
6						
5						
4						
3						
2				CHECKED BY:	DATE:	
1						

Landmark

Landmark Products Limited. A.B.N. 99 112 000 843 55-57 Kabi Circuit, Deception Bay

Queensland 4508

PH: 1300 768 230 FAX: 1300 768 260 P.O. Box 603, Deception Bay www.landmarkpro.com.au

landmark@landmarkpro.com.au

CLIENT NAME			OJECT No.	PAGE
GOULBURN MULWARE	E COUNCIL	33	812	A3
PROJECT GENERAL CEMETERY, SYDNEY ROAD, GOULBURN, NSW, 2580 K9503 "CARETAKER" 1C1D (SKILLION) RESTROOM			TE:	DRAWN
			/11/17	MAF
			AWING No.	SCALE
N9303 CARETAKER TOTO (SKILLION) RESTROOM		33	812	NOTED
DRAWING TITLE		SH	EET No.	REV.
BA - ELEVATIONS		10)2	0